



T. 37 S., R. 5 W., W.M.

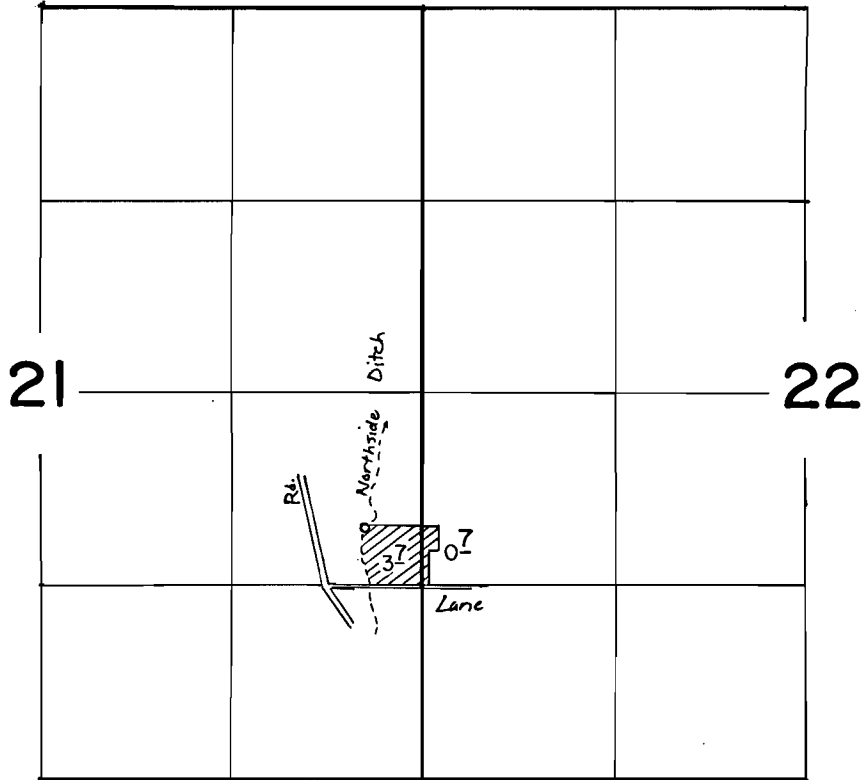

1" = 1320'

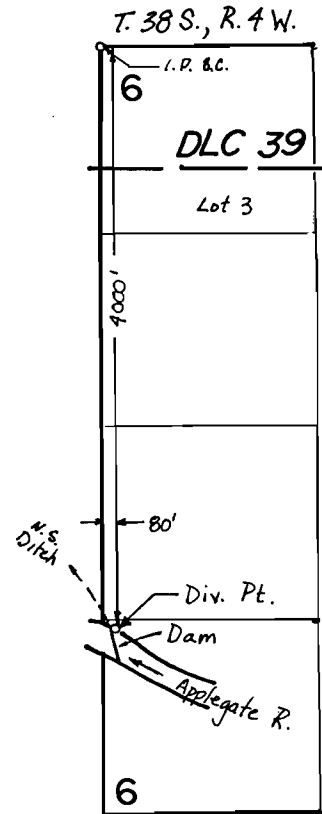

**FINAL PROOF SURVEY**  
UNDER

62119    46842  
Application No. 52042. Permit No. 39220.....  
IN NAME OF

BRUCE A. FAIN

Surveyed Aug 18, 1983, by B. S. JAMES  
June 16, 1982, B. R. SUND