90684

T. 33 S., R. 6 W., W. M.

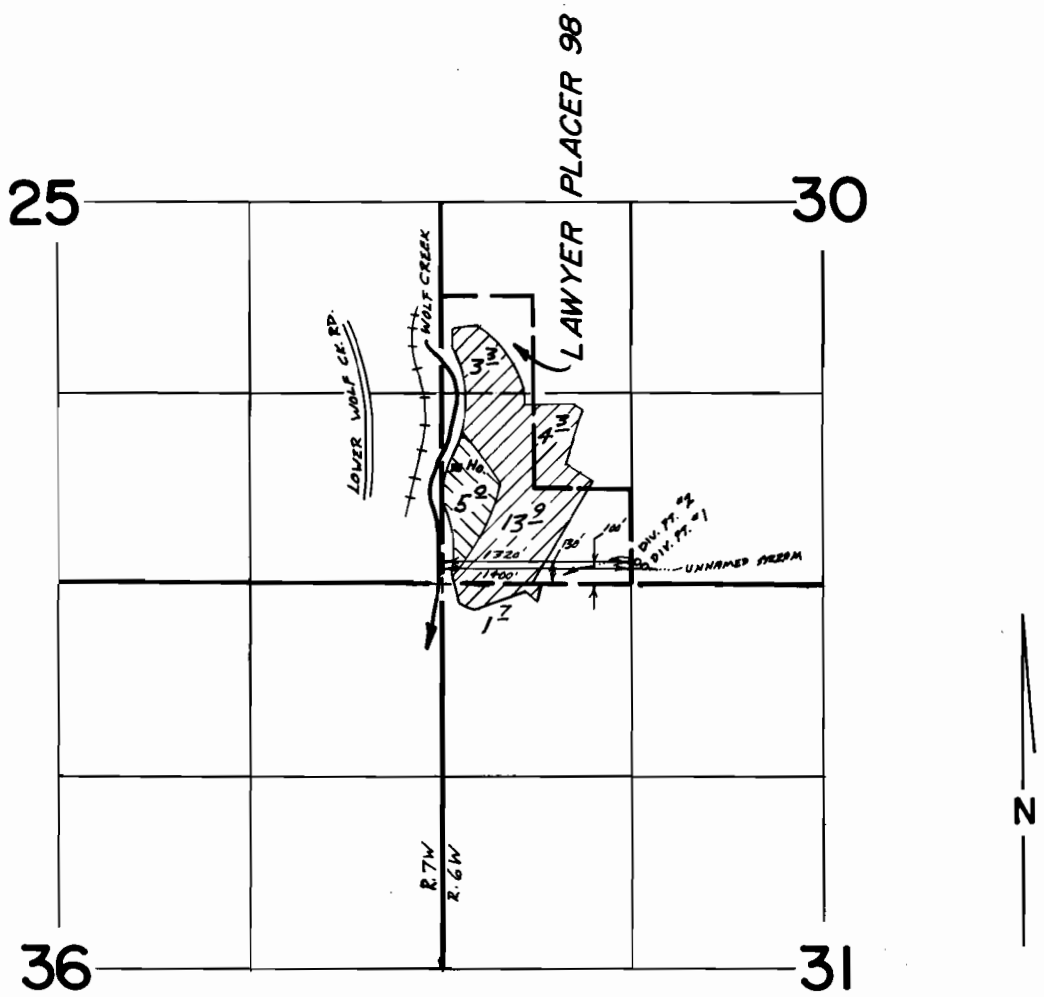

Scale 1" = 1320' SUPPLEMENTAL

PRIMARY

~~Primary~~

~~Supplemental~~

FINAL PROOF SURVEY
UNDER

Application No. 54888 Permit No. 41235

IN NAME OF

NOMENUS, INC.

Surveyed August 28 19 84, by J.R. WOODROOF

41033-170-1542

JRW