


T.37 S., R.5 W., W.M

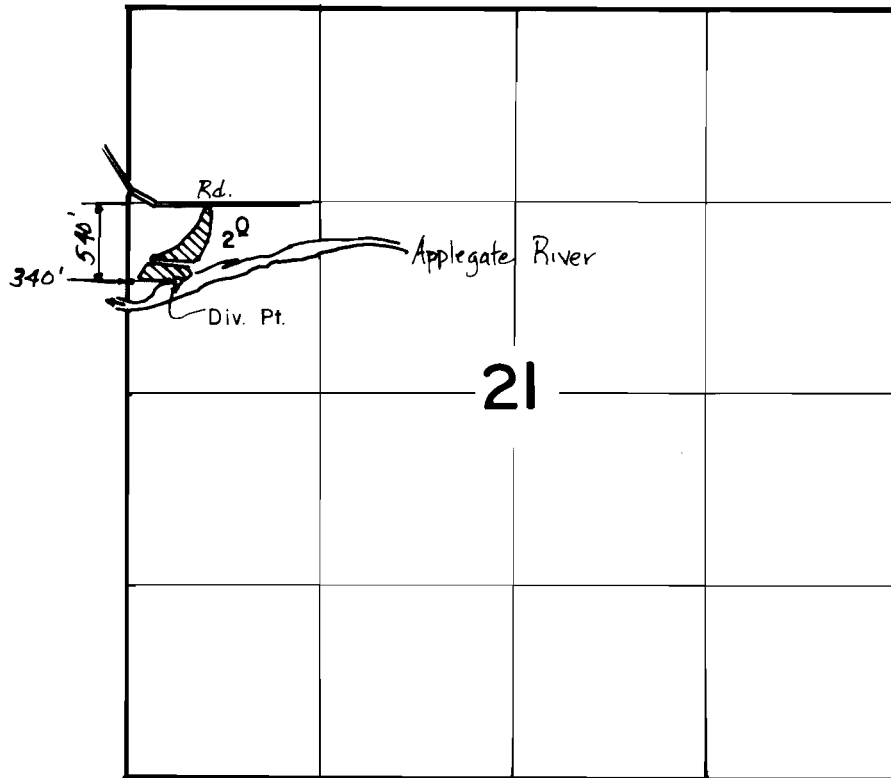

FINAL PROOF SURVEY UNDER

Application No. 55120 Permit No. 41455
IN NAME OF

DONALD D. WIER

Surveyed March 29, 1982., by B. R. SUND