


T. 37 S., R. 6 W., W.M.

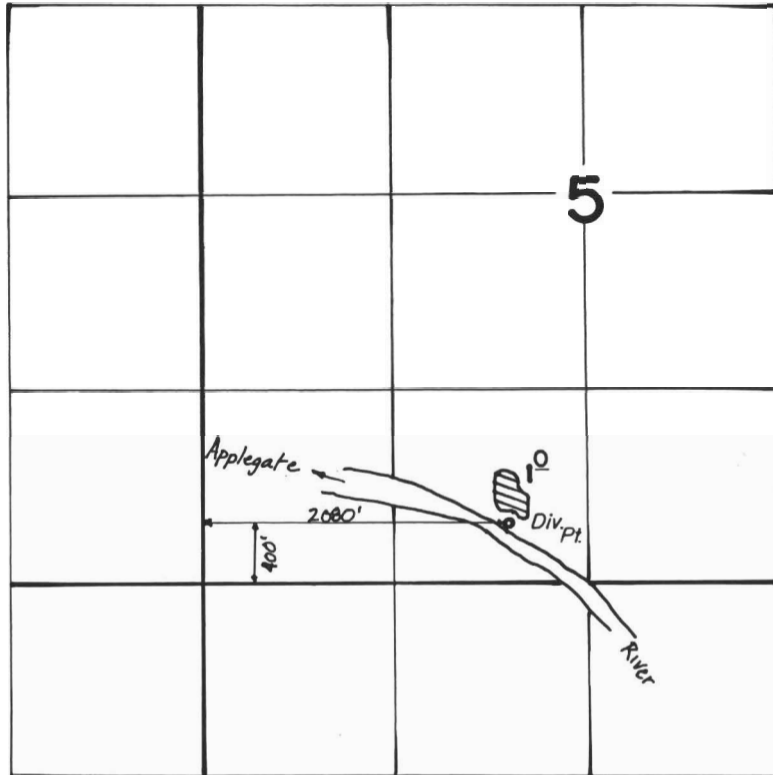

FINAL PROOF SURVEY
UNDER

Application No. 62194 46073
59539... Permit No. 44920.....

IN NAME OF

WILLIAM H. PINALTO

Surveyed AUG. 10. 1982., by B. S. JAMES.....