


# T. 37 S., R. 6 W., W.M.

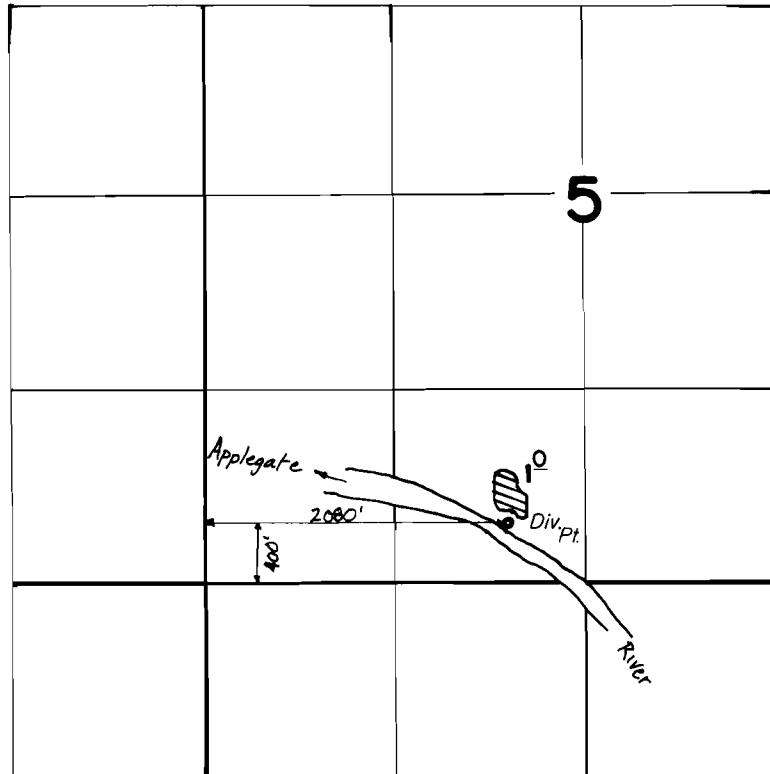

## FINAL PROOF SURVEY UNDER

Application No. 62194 46073  
59539 Permit No. 44920.....

IN NAME OF

**WILLIAM H. PINALTO**

Surveyed AUG. 10. 1982., by B. S. JAMES.....