


T.37S., R.4&5W., W.M.

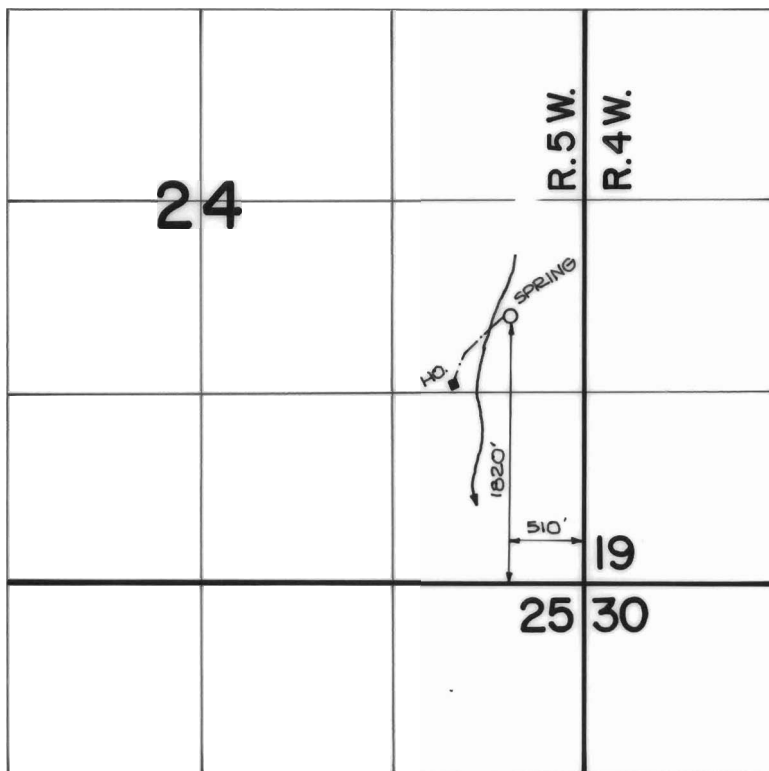

FINAL PROOF SURVEY
UNDER

Application No. **60051** Permit No. **45064**...
IN NAME OF

SUSAN LIEBES

Surveyed **MAY 14**, 19**82**, by **B. SUND**.....