


T.37S., R.5W., W.M.

Sec. 18

SE 1/4 SW 1/4

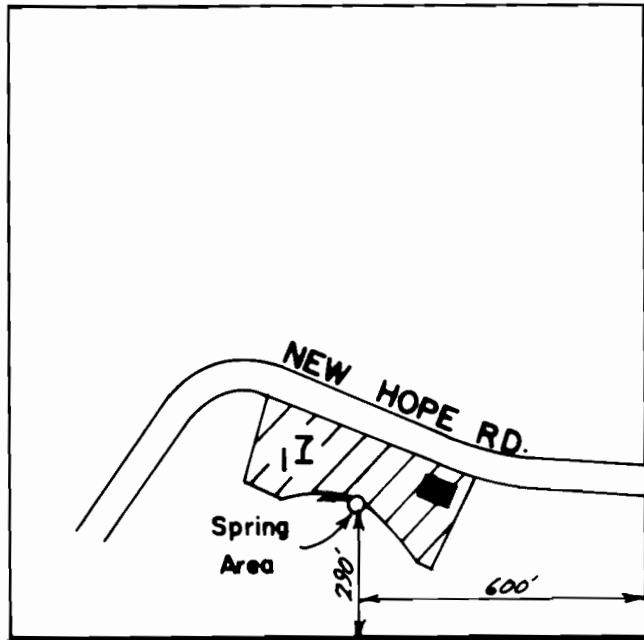

Scale 1" = 400'

FINAL PROOF SURVEY
UNDER

Application No. 60472... Permit No. 45237...
IN NAME OF

VIRGINIA FAY & or GLENN E. BASTIAN

Surveyed May 14, 1982, by B.R. SUND