


44367  
56035

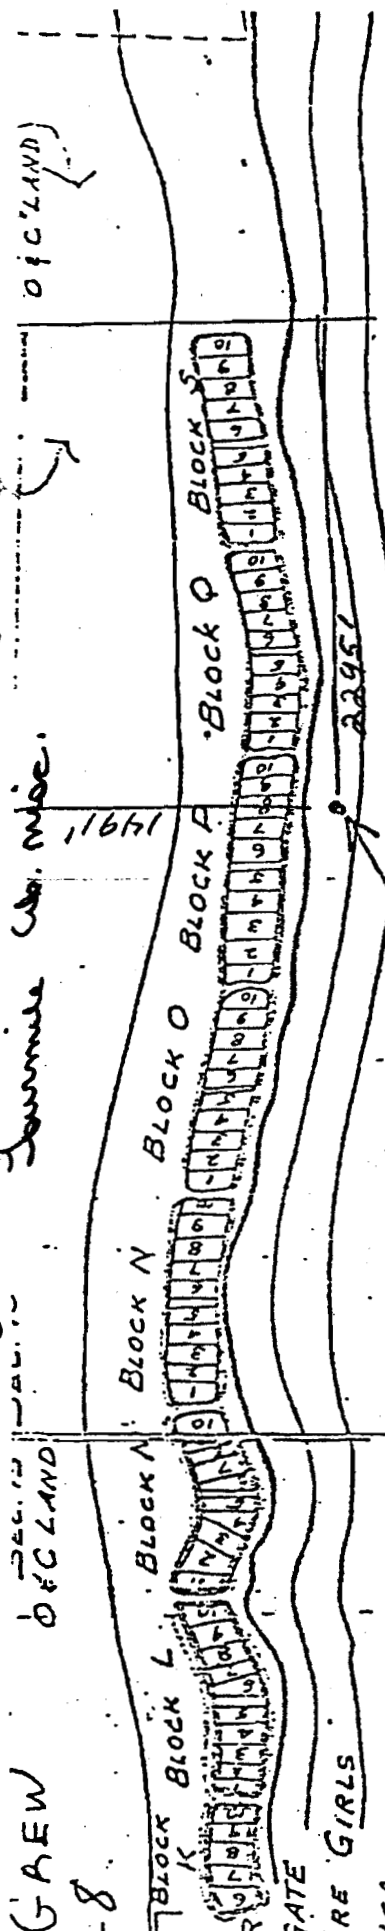

RECEIVED  
JUL 11 1979  

POINT OF DIVERSION IS 1491 FT E X 2295 FT  
S OF THE N CORNER OF SEC 10, T37S, R5E, WM.  
POINT OF USE IS LOT 8, BLK P OF LAKE OF  
THE WOODS SUMMER HOME TRACT

# LAKE OF THE WOODS

Application No. 58901  
Permit No. 44367

