

44686

GORDON, WM L.
L-2, B-P, L.O.W

SEC. 15
OFC LAND

SEC. 10

OFC LAND

Block K
Block L
Block M
Block N
Block O
Block P
Block Q
Block R
Block S
Block T
Block U
Block V

PRLEGATE
IMP FIRE GIRLS
AMERICA

22951


POINT OF DIVERSION - 1821' E x 2295' N
OF THE SW CORNER OF SEC 10, T37S, R5E.
POINT OF USE - LOT 2, BLK P OF LAKE OF
THE WOODS SUMMER HOME TRACT.

44686

Application No. 44686
Permit No. 44686

LAKE OF THE WOODS

N →

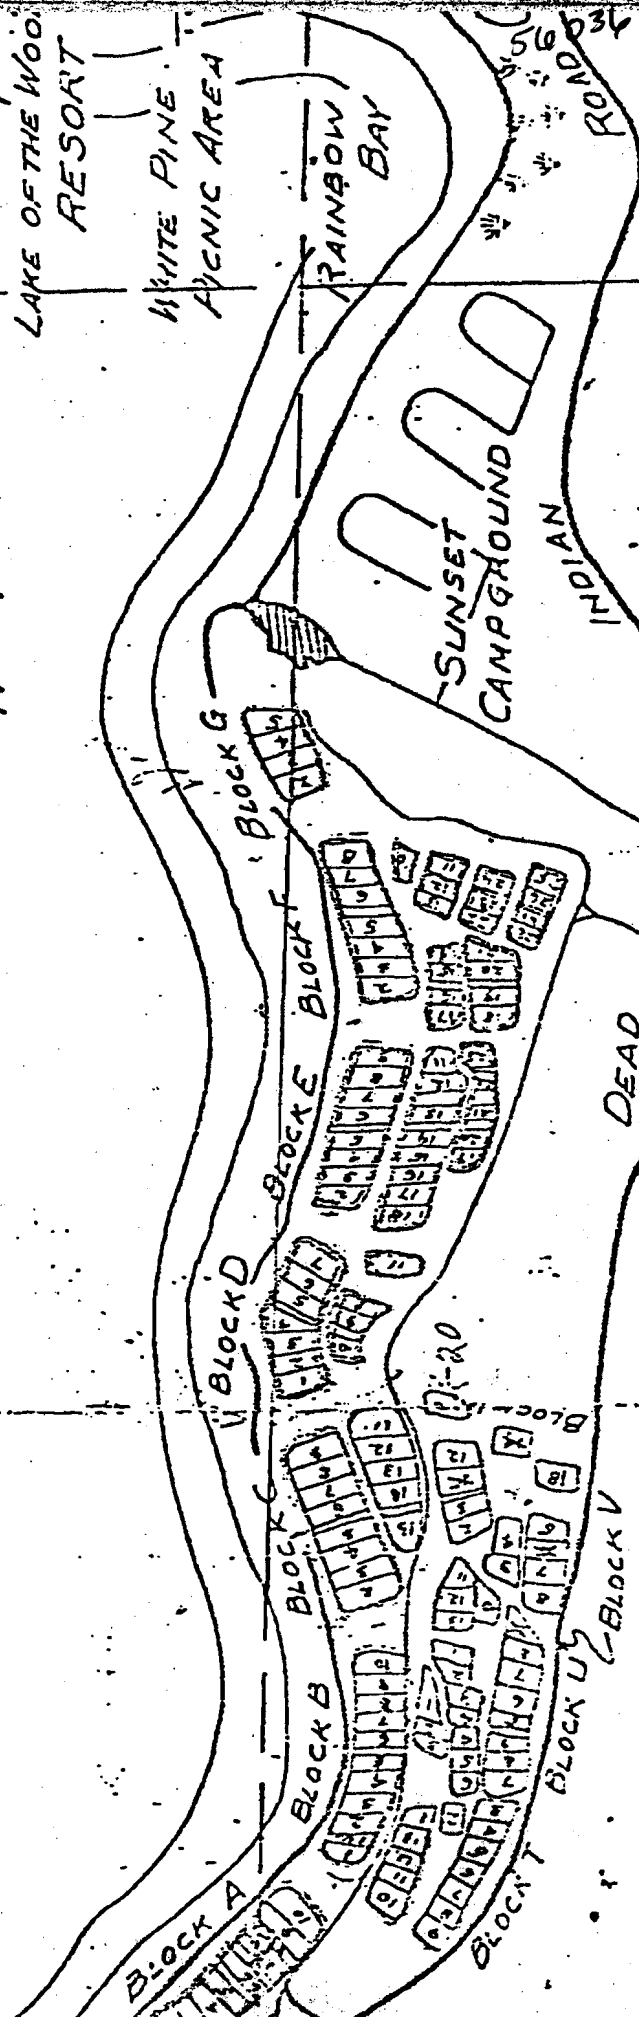

50634

DEAD