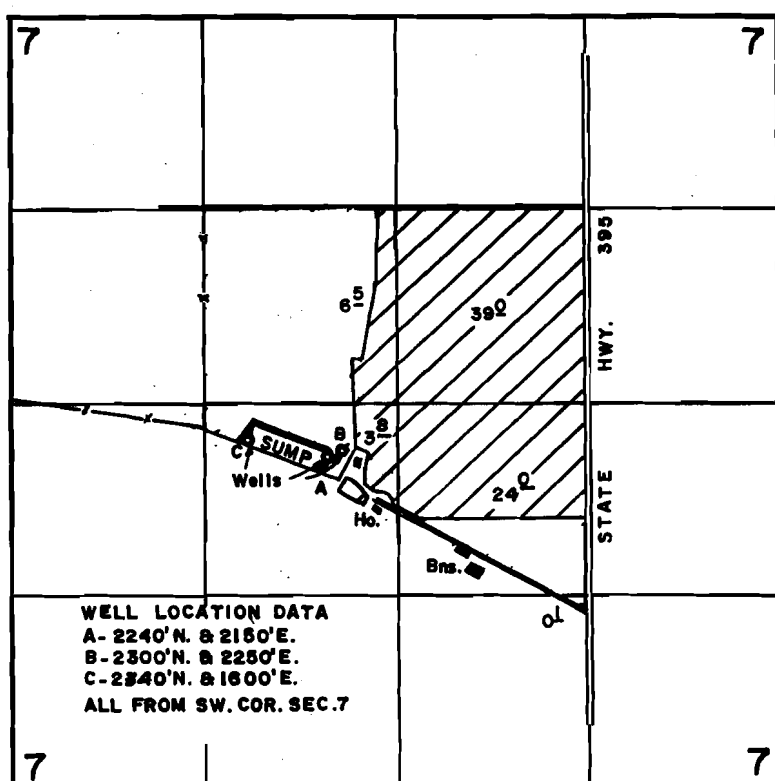


T.36S. R.21E. W.M.

**FINAL PROOF SURVEY**
UNDERApplication No. G-6190. Permit No. G-5864...
IN NAME OF

.....RICHARD.....WEEKLY.....

Surveyed Oct....17... 1979., by S.C..BROWN.....

REVISED 3/27/87 LMN

PD-1979A-CN2-4KK-154 802