


T.28S., R.15E., W.M.

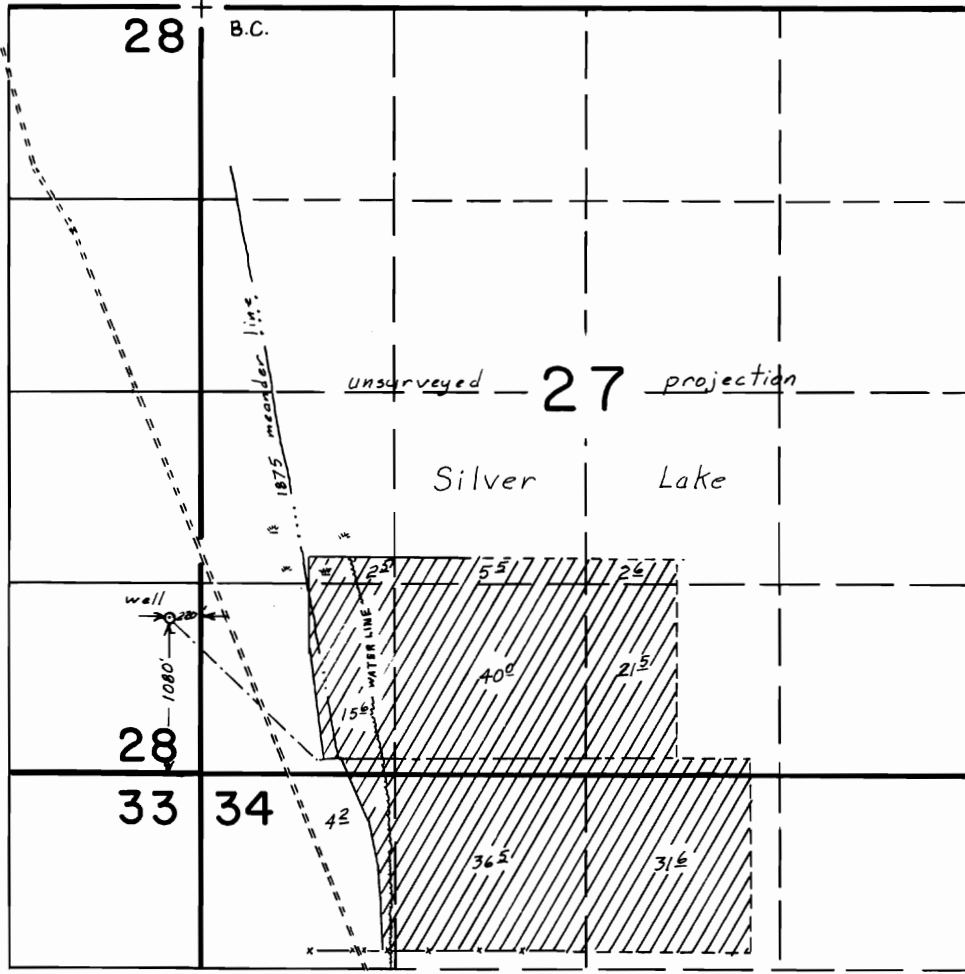

SCALE : 1" = 1320'

FINAL PROOF SURVEY
UNDER

Application No. G-10123.. Permit No. G-9201.....
IN NAME OF

.....**JEREMIAH O'LEARY**.....

Surveyed MAY...7..... 1986., by LESLIE...OLSON...