


19

IN 15E 20

9.2-1945 ✓ 7-1945 ✓

Emerson Bros. 1870

26-1870 ✓ 3.9-1870 ✓  
8.9-1945 ✓ 4-1945 ✓

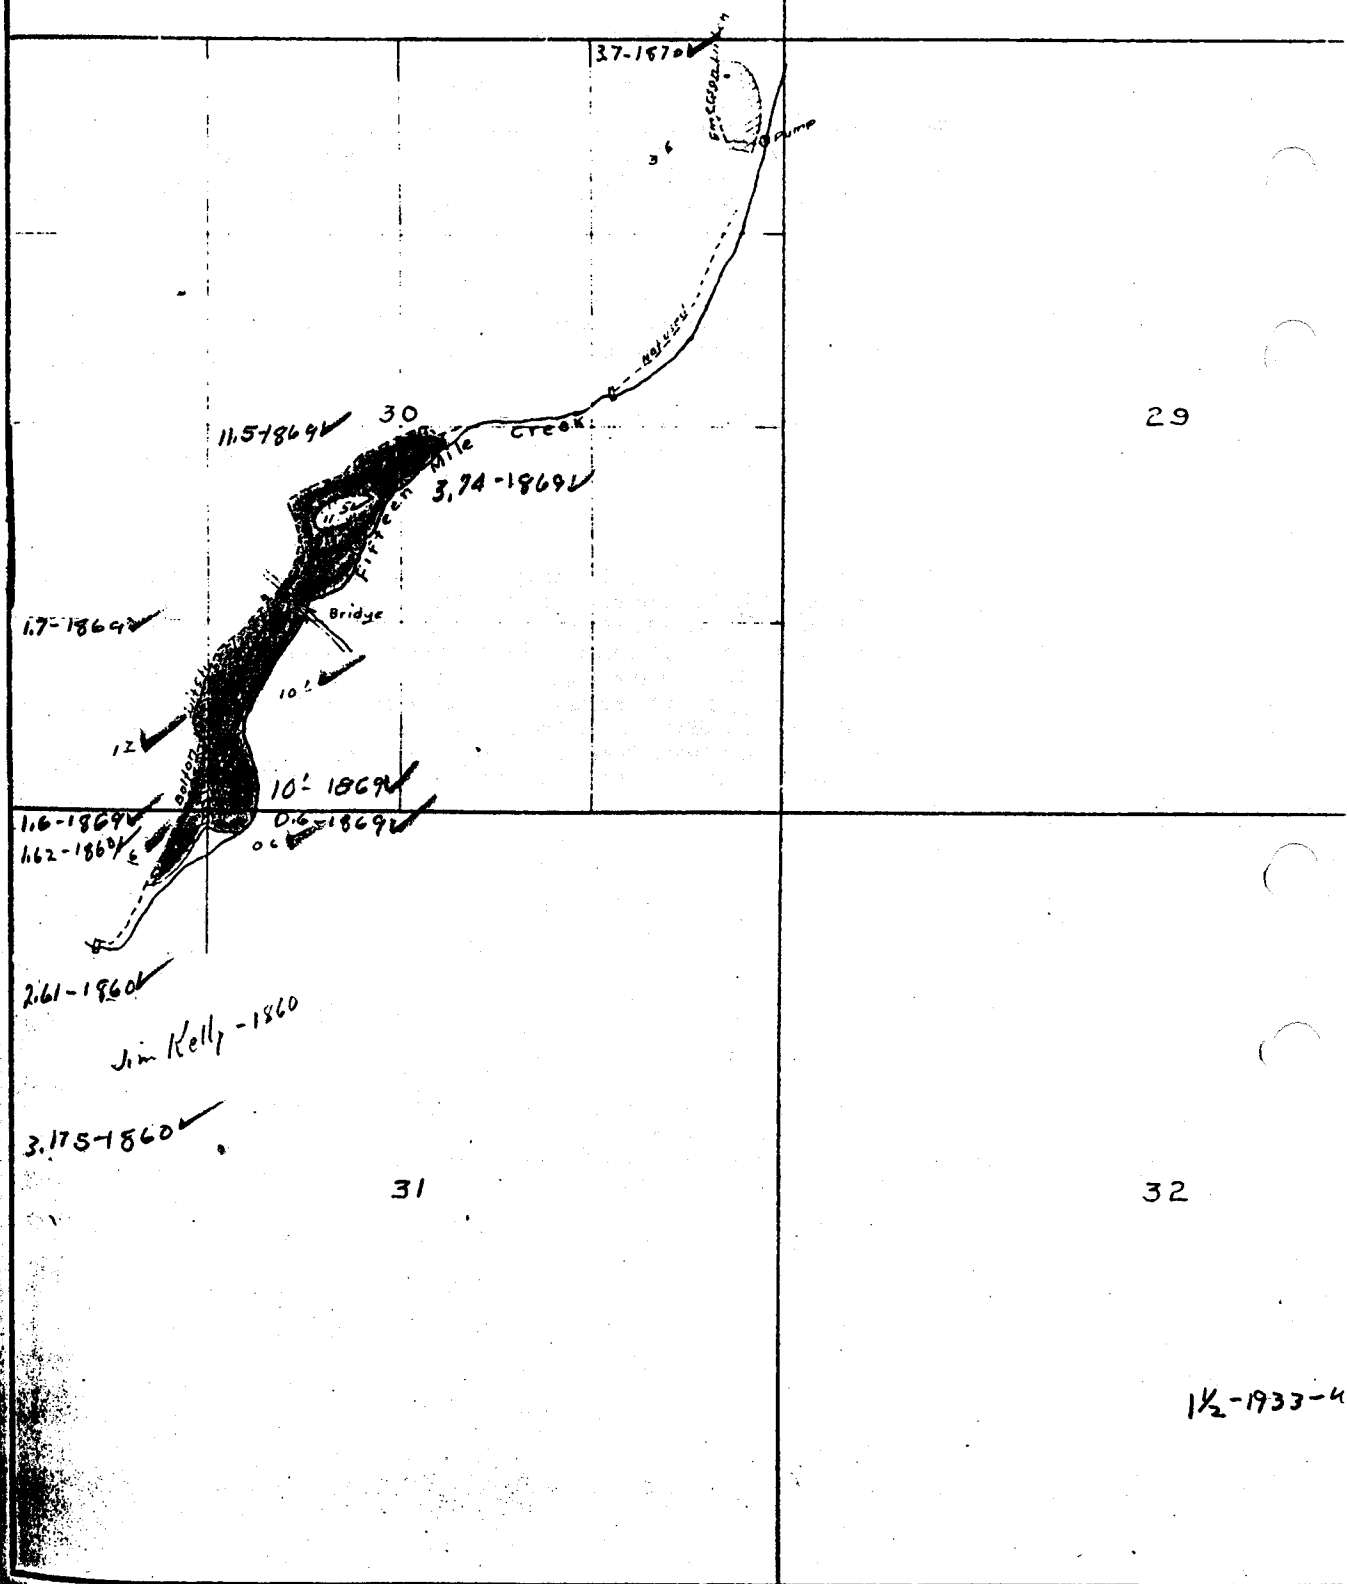

29

31

32

1/2-1933-4