


# T. 17S. R. 2W. W.M.

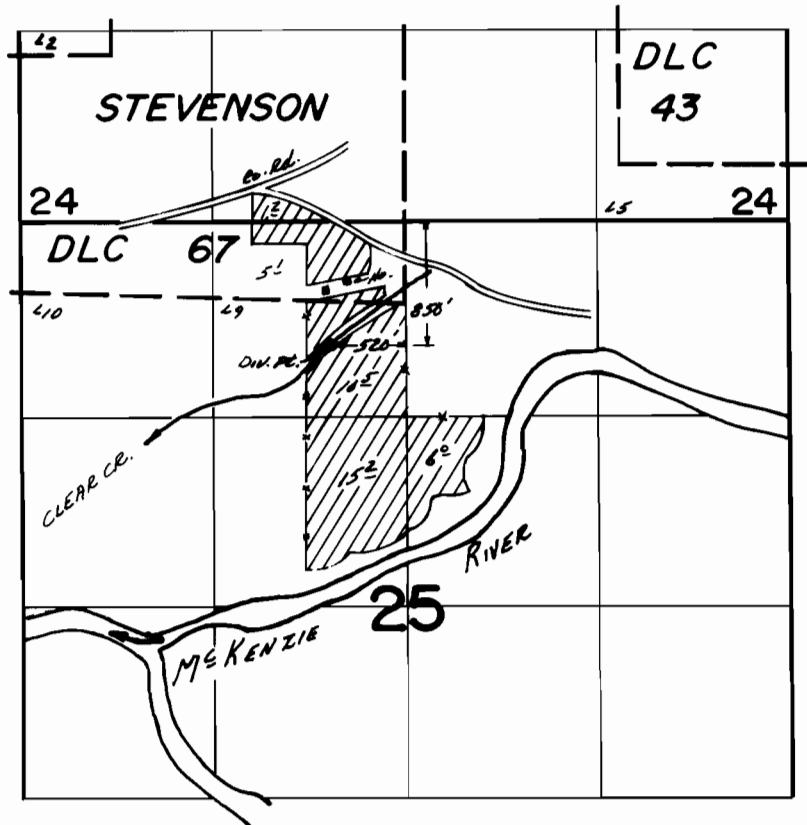

## FINAL PROOF SURVEY UNDER

Application No. 52547.. Permit No. 39648....  
IN NAME OF

.....**EDWARD WATSON**.....

Surveyed June 28, 1979, by S.C. BROWN.....