
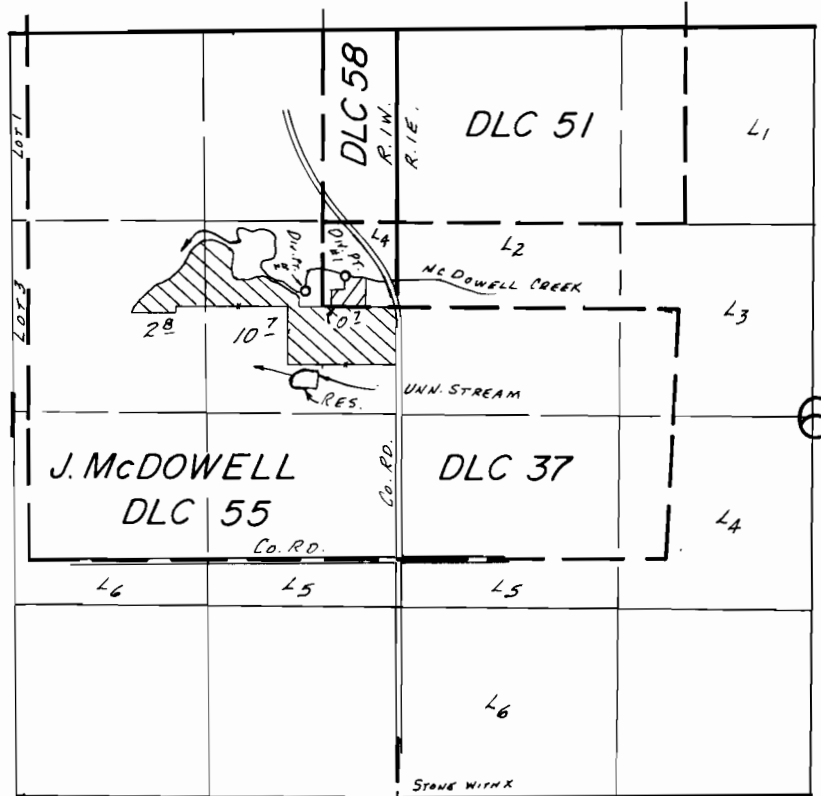


T.13S., R.1W. & 1E., W.M.

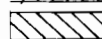

DAM LOC: 2900' N. & 720' W., Div. Pts. Loc.: #1-3600' N. & 350' W.,
#2-3500' N. & 630' W., ALL FROM SE COR. SEC. 1.

 Div. Pt. #1
 Div. Pt. #2

SCALE: 1" = 1320'

FINAL PROOF SURVEY

UNDER

51385 38852
R-63966 R-8546
Application No. 63199 Permit No. 47217
IN NAME OF

FLOYD M. & REMONA M. SIMPSON

Surveyed June 13, 1986, by B. W. BISHOP