


T. 13S., R. 2W., W.M.
SEC. 26

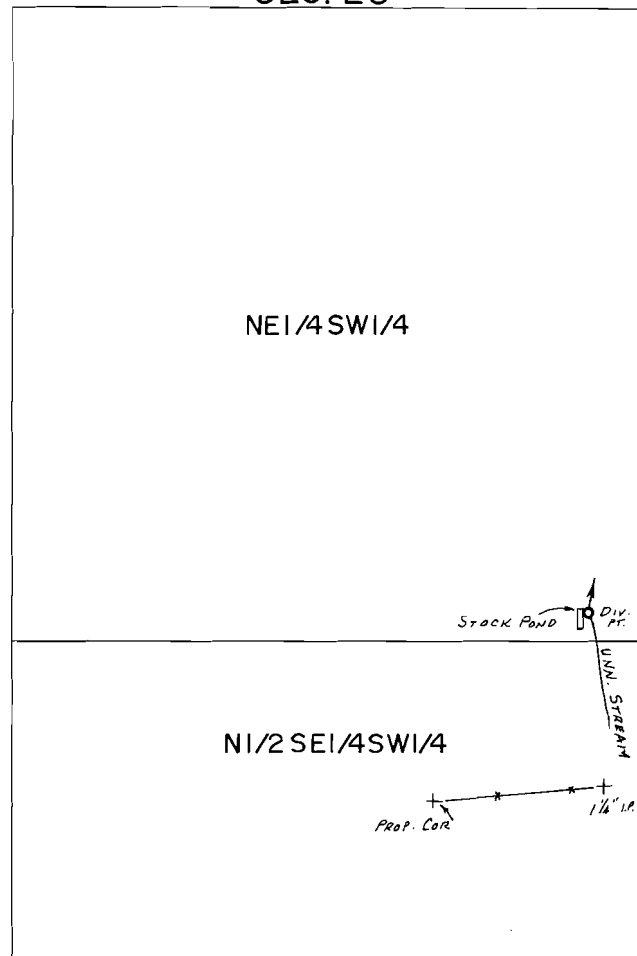

DIV. PT LOC.: 60' N. & 120' W. FROM SEC. COR. NE 1/4 SW 1/4

SCALE: 1" = 400'

FINAL PROOF SURVEY

UNDER

Application No. 55935.. Permit No. 42504....
IN NAME OF

.....RICHARD M. GOSNEY.....

Surveyed June 10, 1986, by B.W. BISHOP.....

11/21/86
BWB
PTS 1986B