


T. 10S., R. 1W., W.M.

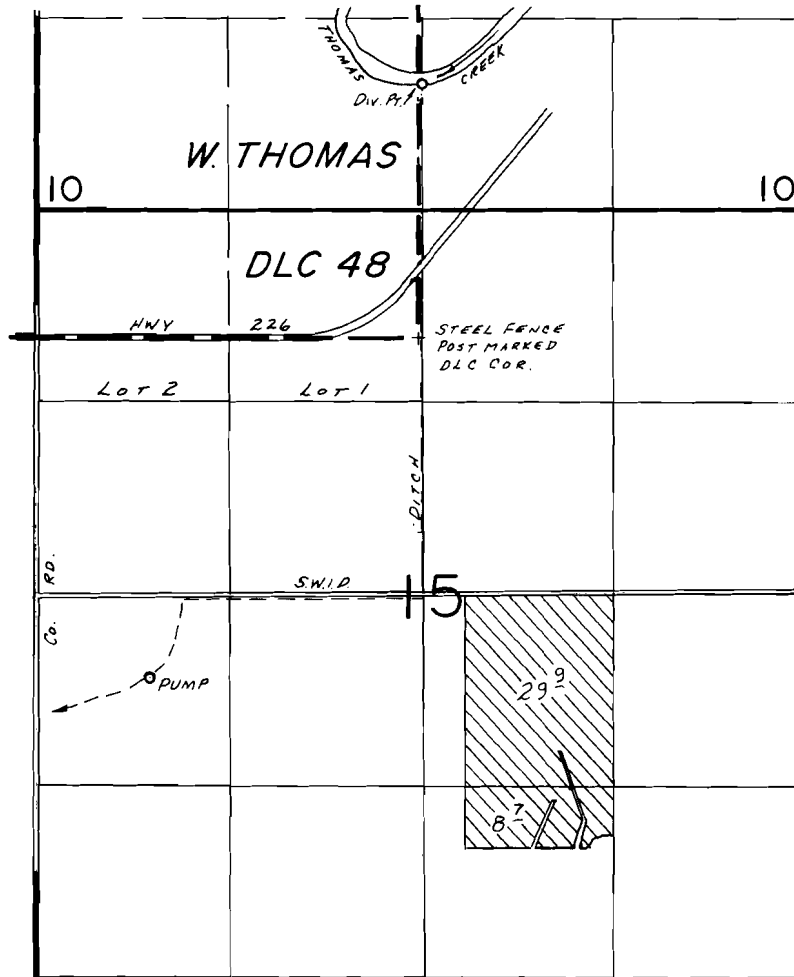

DIV. PT. LOC: 1750' N. & 40' E. FROM SEC COR W. THOMAS DLC 48.

SCALE: 1" = 1320'

FINAL PROOF SURVEY UNDER

Application No. 60258.. Permit No. 45510.....
IN NAME OF

THOMAS W. & JOYCE E. COMMONS

Surveyed Sept. 4... 1985, by T.M. WARREN.....
May 14 1986 B.W. BISHOP