


T. 10S., R. 1W., W.M.

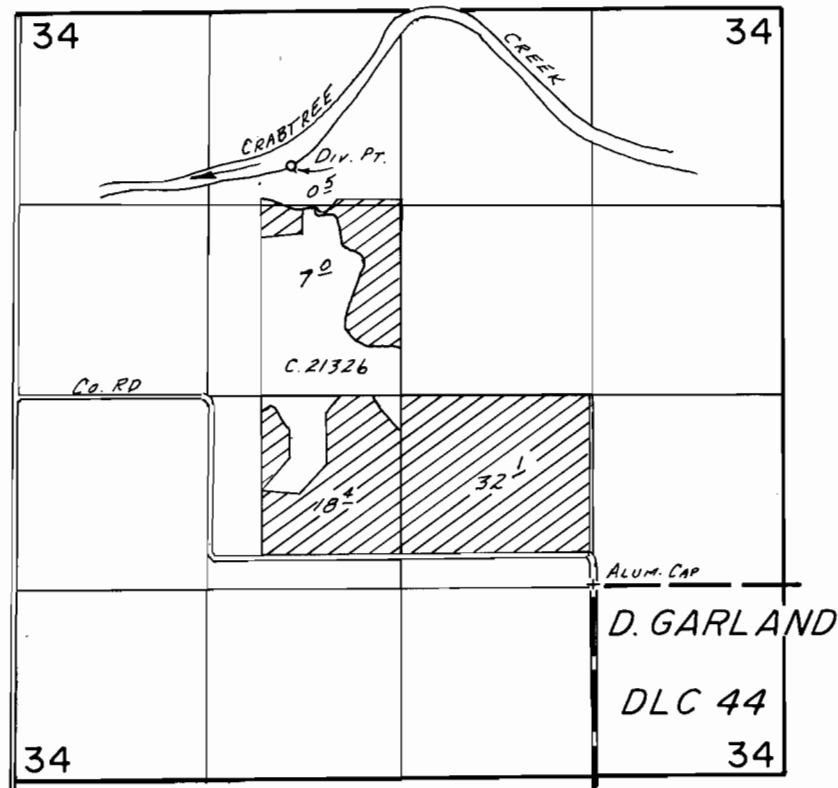

Div. Pt. Loc.: 2910' N. & 2060' W. FROM NW COR. D. GARLAND DLC 44.

SCALE: 1"=1320'

FINAL PROOF SURVEY UNDER

Application No. 61221... Permit No. 45578
IN NAME OF

CHARLES T. & DONNA M. CARPENTER

Surveyed June 11, 1986, by B.W. BISHOP