


# T.10S., R.2W., W.M.

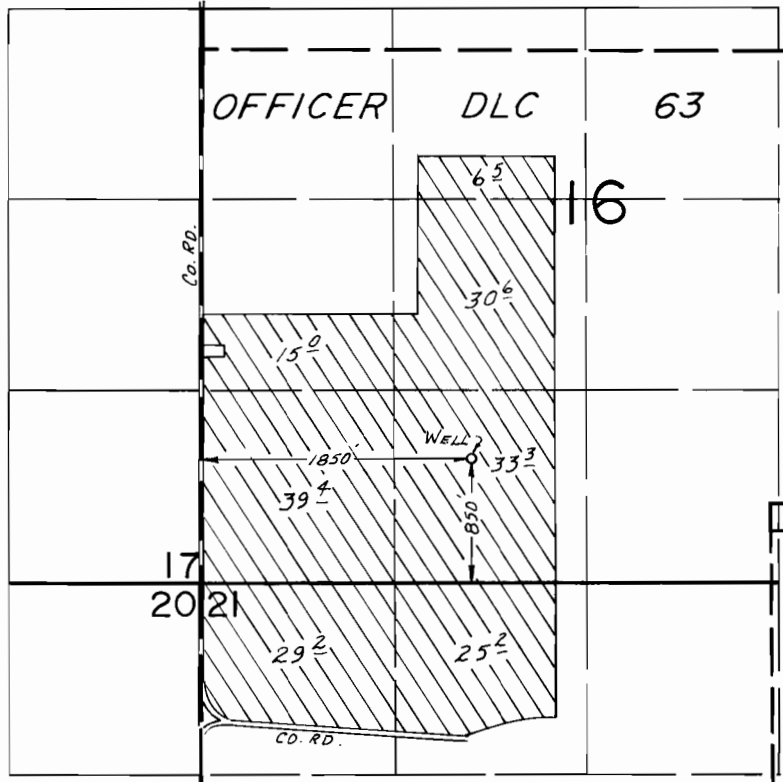

SCALE: 1" = 1320'

## FINAL PROOF SURVEY UNDER

Application No. G-9469 Permit No. G-8922....  
IN NAME OF

.....MILLER FOREST.....

Surveyed Oct. 12..... 19.83, by M. CAHILL.....