



# T.18S.,R.46E.,W.M.

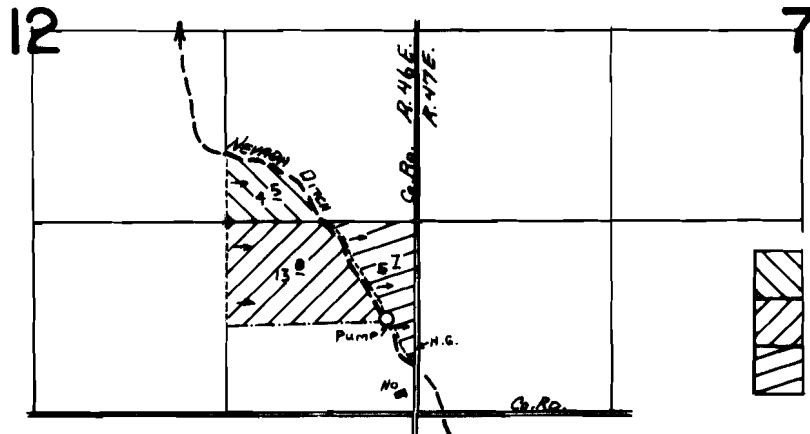

# T.18S.,R.45E.,W.M.

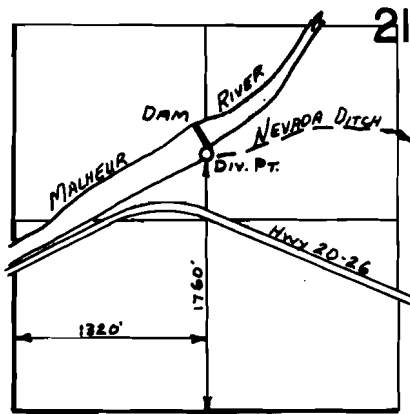

## FINAL PROOF SURVEY UNDER

Application No. ..57028.. Permit No. ...43153.....  
IN NAME OF

**WARMSPRINGS IRRIGATION DISTRICT**

Surveyed .Aug..25.. 19.83., by ..L...M...TOLL.....