


T.22S.,R.45E.,W.M.

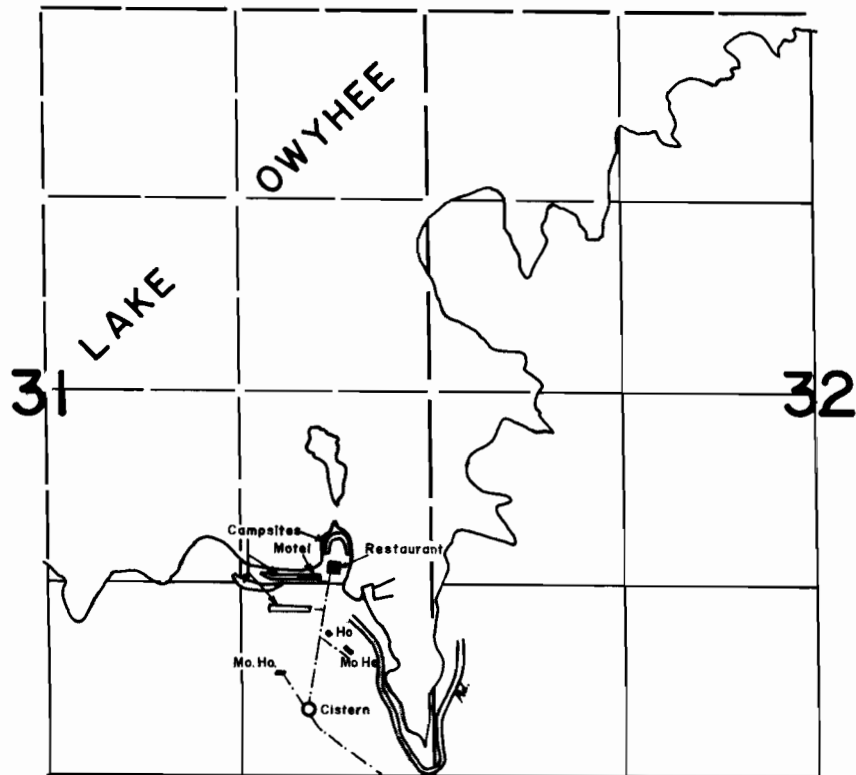

Spring Location: within the NW 1/4 SW 1/4 Section 5, T.23S.,R.45E.,W.M.  
being 2464.04 ft. N. & 1910.87 ft. W. from the S 1/4  
Corner of Section 5

**FINAL PROOF SURVEY**  
UNDER

Application No. .59922. Permit No. .45055.....  
IN NAME OF

.....LAKE OWYHEE RESORT.....

Surveyed Aug. 20. 1983, by L.M. TOLL.....