


T.18S.,R.45E.,W.M.

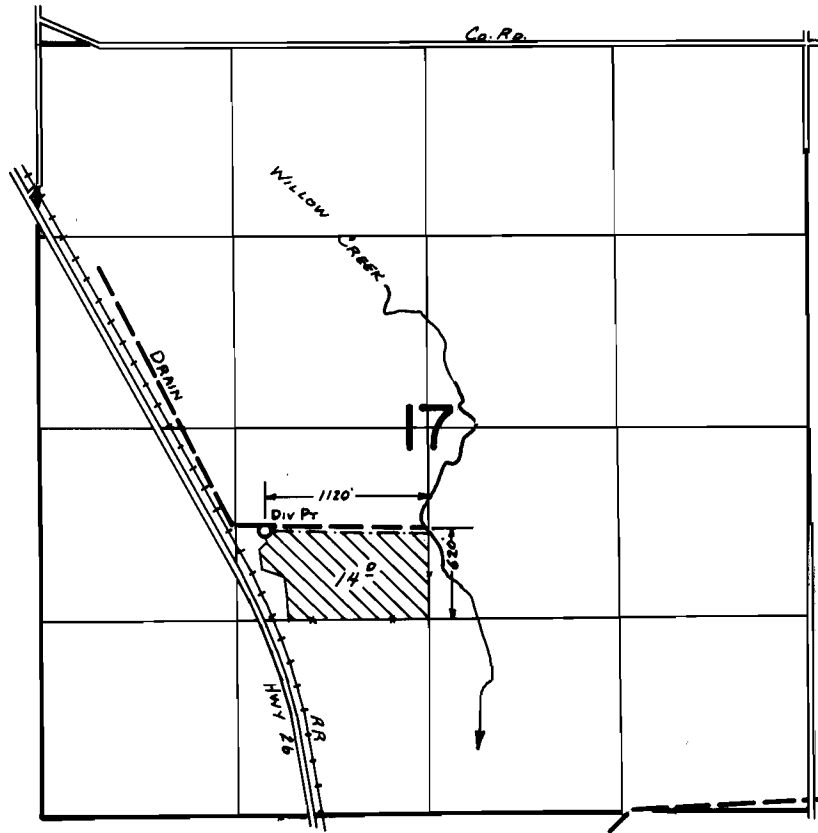

FINAL PROOF SURVEY
UNDER

Application No. .61834... Permit No. .46338.....
IN NAME OF

SUSAN DENTINGER

Surveyed .Aug..23.. 19.83., by .L..M..TOLL.....