


# T.6S. R.1W., W.M.

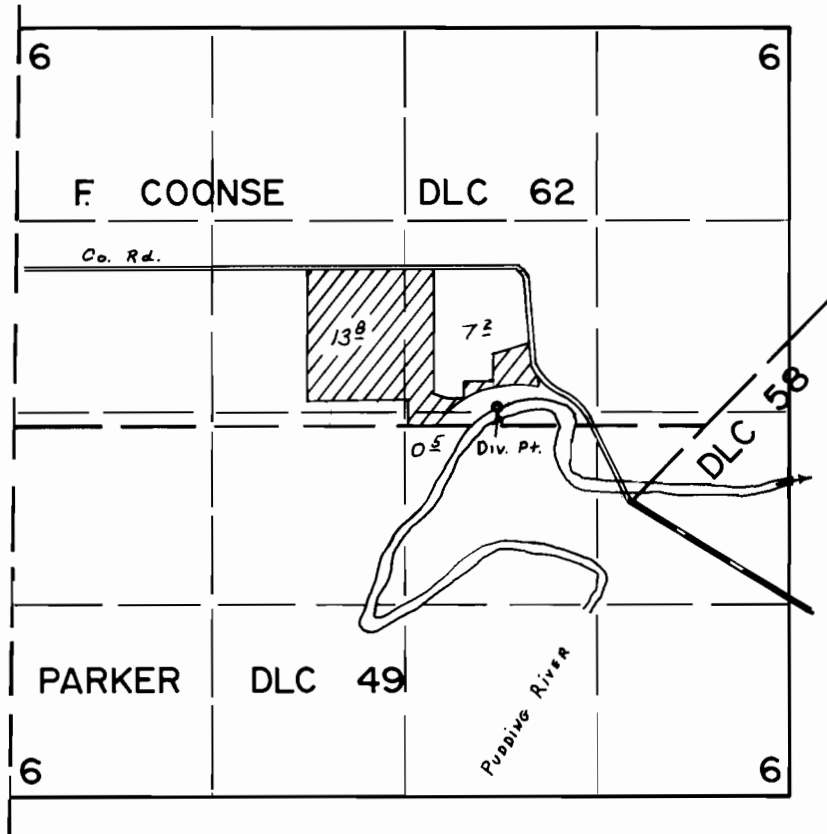

## FINAL PROOF SURVEY UNDER

Application No. 53010... Permit No. 40012.....  
IN NAME OF

.....PETER J. MILLER.....

Surveyed APR. 26. 1979., by L. H. NUNN.....