


T.6S., R.1E., W.M.

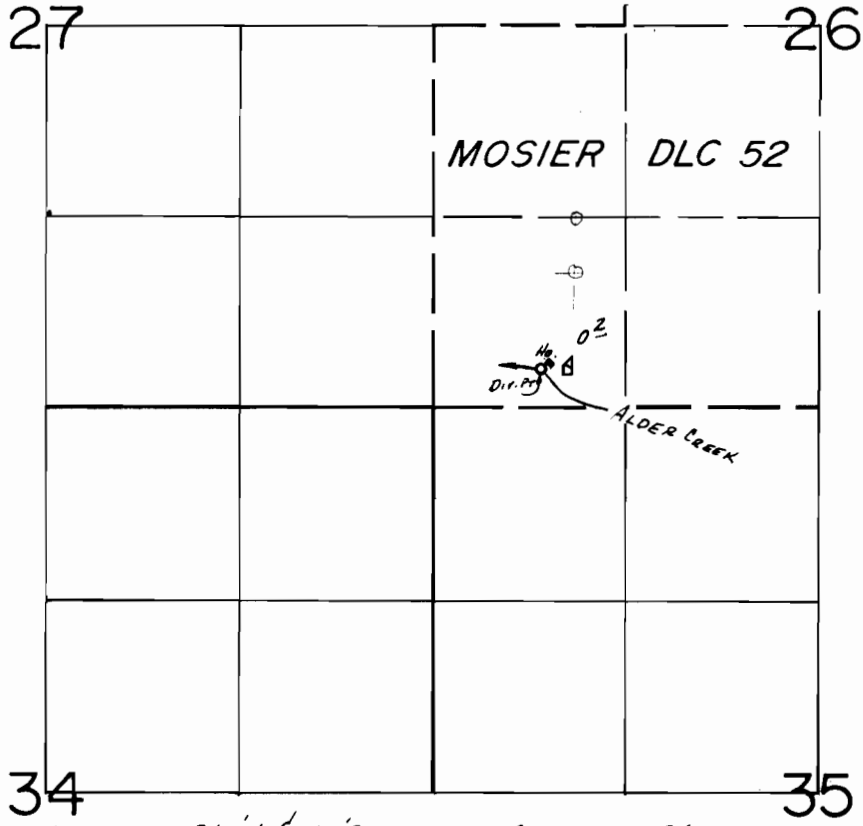

Div. Pt. Loc. 260' N. & 740' E. FROM SW COR. SEC. 26.

SCALE: 1" = 1320'

**FINAL PROOF SURVEY**  
UNDER

Application No. .56054. Permit No. 41948.....  
IN NAME OF

.....MARY K. BATES.....

Surveyed ..Apr. 9..... 19.86, by J.M. WARREN.....

4/29/86  
JWB