


T.5S. R.1W., W.M.

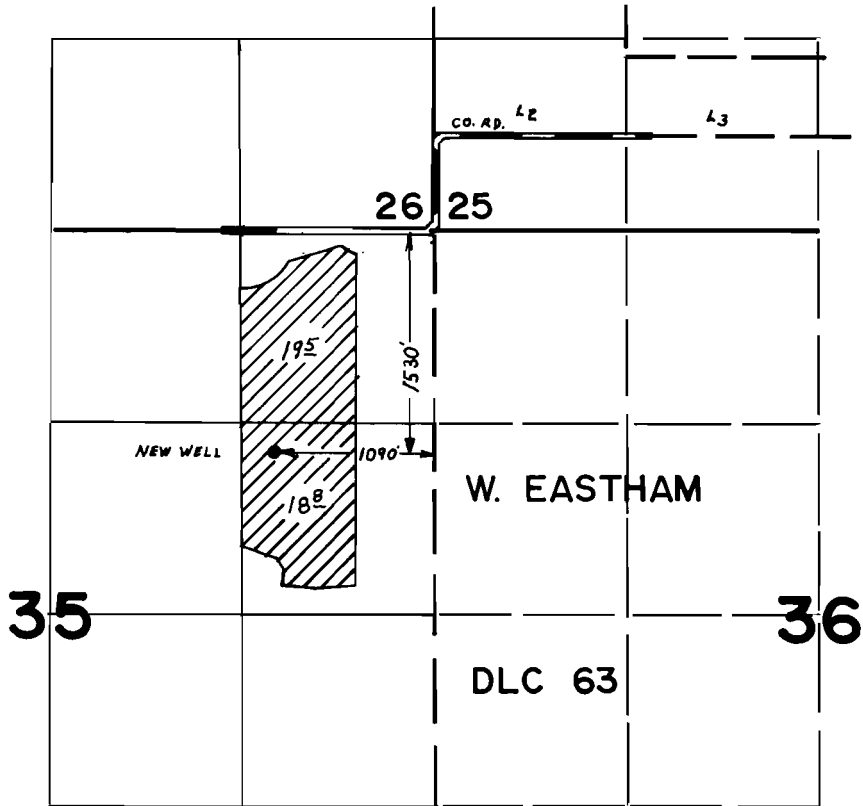

FINAL PROOF SURVEY UNDER

Application No. G-6410 Permit No. G-5471
IN NAME OF

FRANZ GREVE

Surveyed JUNE 8, 1979, by L.H. NUNN