


T.8S., R.2W., W.M

Sec. 21

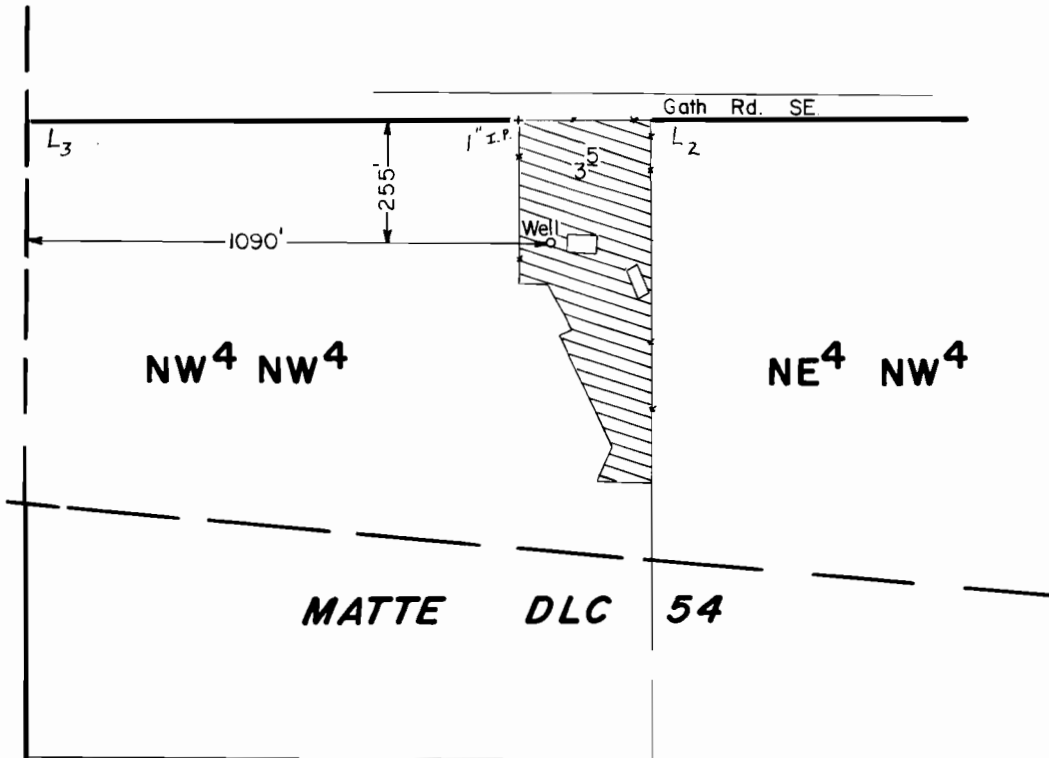

Scale : 1" = 400'

FINAL PROOF SURVEY UNDER

Application No. G-6559.. Permit No. G-6161.....
IN NAME OF

RICHARD T. VAN SANTEN

Surveyed April 29, 1986, by T. Warren.....