


T.6S. R.2W., W.M.

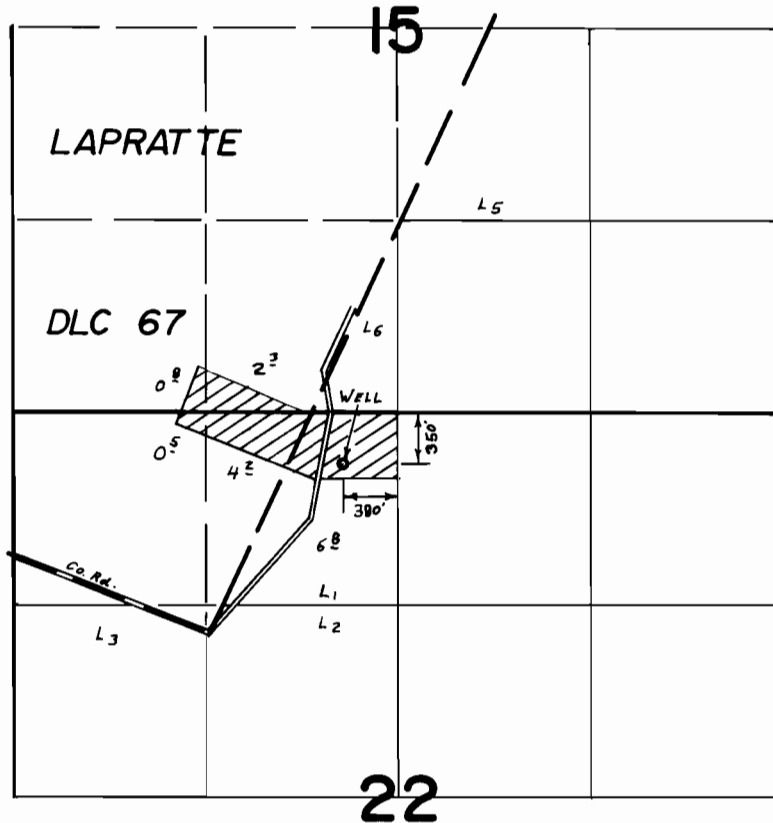

FINAL PROOF SURVEY UNDER

Application No. G-6887.. Permit No. G-6418.....
IN NAME OF

.....FRANK HENNY JR.....

Surveyed APR. 25... 1979., by L.H.NUNN.....