T.6S. R.3W., W.M.

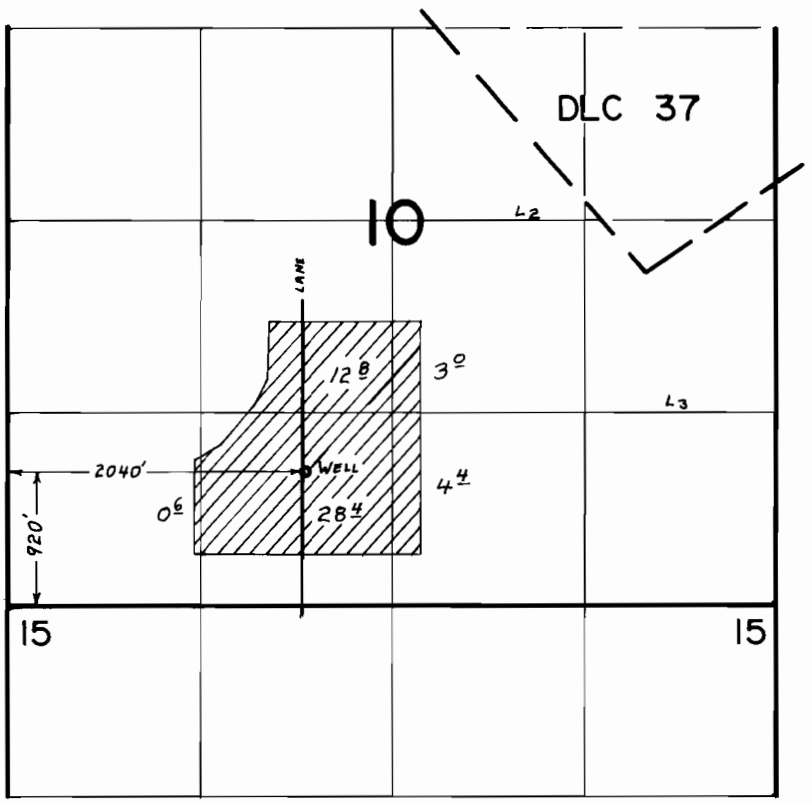

FINAL PROOF SURVEY

UNDER

Application No. G-6897 Permit No. G-6426

IN NAME OF

GEORGE J. LANDRITH

Surveyed APR 24 1979, by L.H. NUNN

DFN-2LL-75 89