


T.6S. R.1W., W.M.

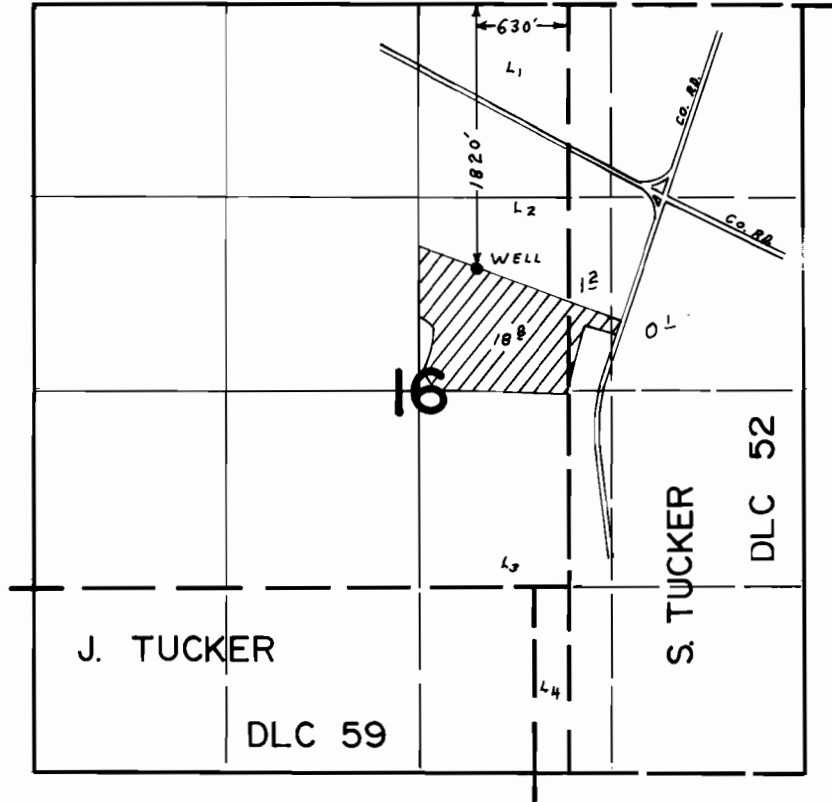

FINAL PROOF SURVEY UNDER

Application No. G-7296 Permit No. G-6718.....
IN NAME OF

.....LEROY DUDA.....

Surveyed APR. 26... 1979., by L. H. NUNN.....