


T. 4S. R. 18 & 2W. W.M.

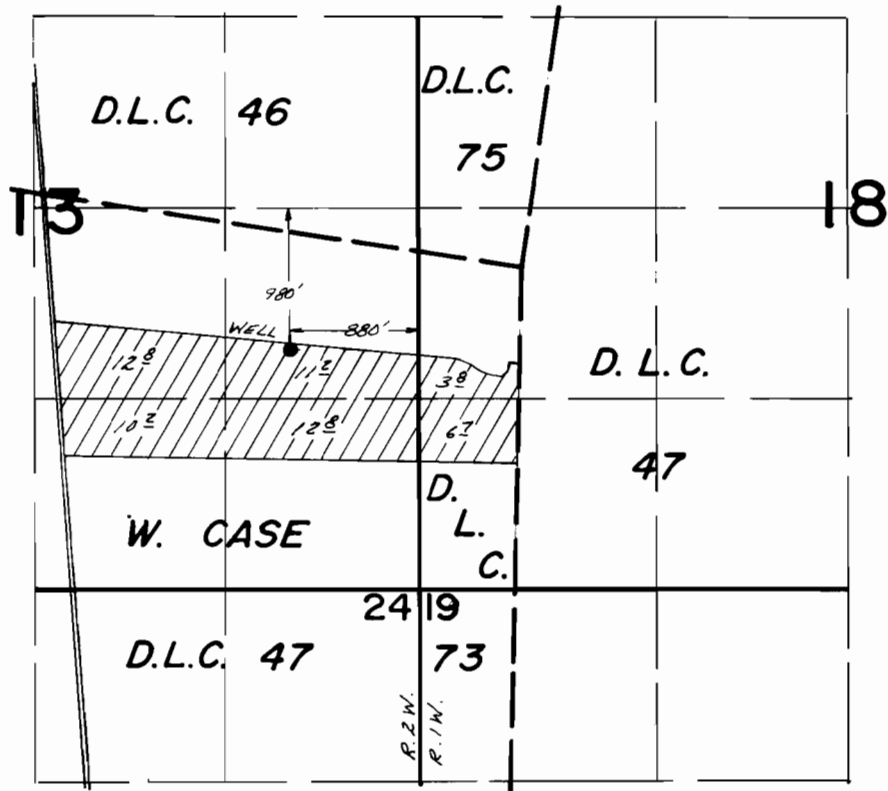

FINAL PROOF SURVEY UNDER

Application No. G-8110. Permit No. G-7492.
IN NAME OF

WALT WILMES FARMS INC.

Surveyed Oct. 3, 1979, by C.R. RODRIGUEZ