


T.6S. R.1W., W.M.

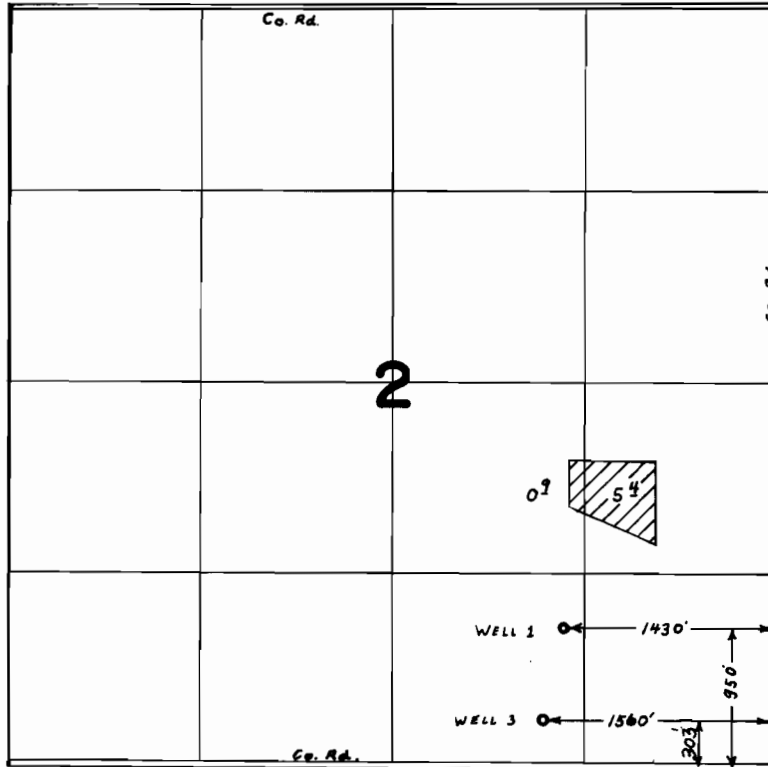

FINAL PROOF SURVEY UNDER

Application No. G-9012.. Permit No. G-8417.....
IN NAME OF

.....WALTER DUDA.....

Surveyed APR. 26. 1979., by L. H. NUNN.....