56073
3.5613

T. 3N., R. 30E., W. M.

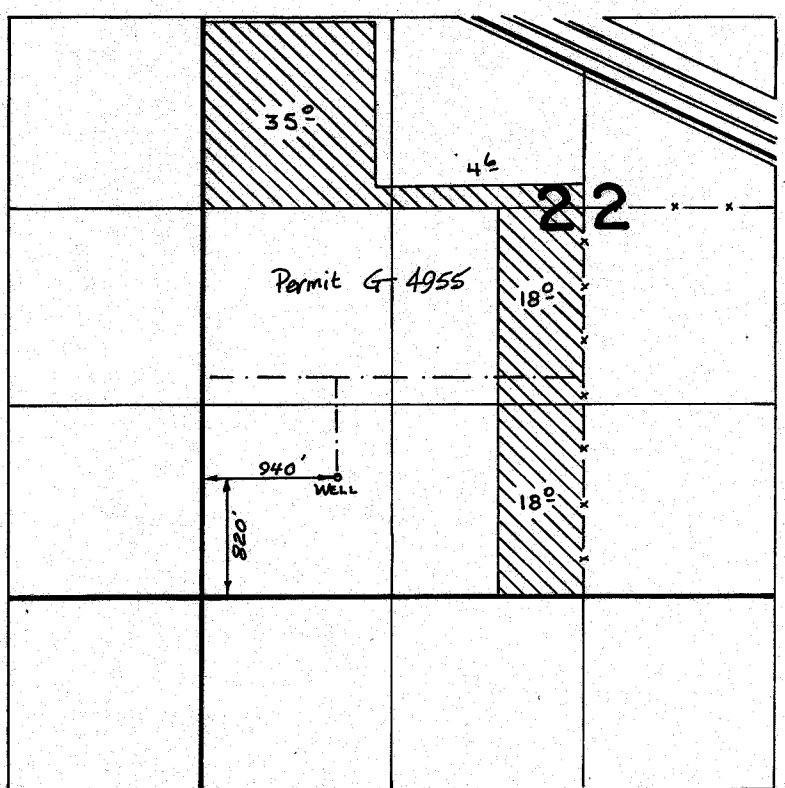

SCALE: 1" = 1320'

FINAL PROOF SURVEY
UNDER

TRANSFER 4203
Application No. G-9236 Permit No. G-8633
IN NAME OF

LEON REESE

Surveyed 11-1 1984, by V. L. Church

NZ-IMM-23