

23920

T. 3 S., R. 1 E., W.M.



### FINAL PROOF SURVEY

UNDER

23920 18840

Application No. 27051 Permit No. 21220

IN NAME OF


CARLETON PARISH FYNN, M. D.

DR. SAMUEL A. & MARGARET M. BRANDON

Surveyed July 29 1953, by H. L. Coffman

DFK-3D-54

# T3S, R1E, WM

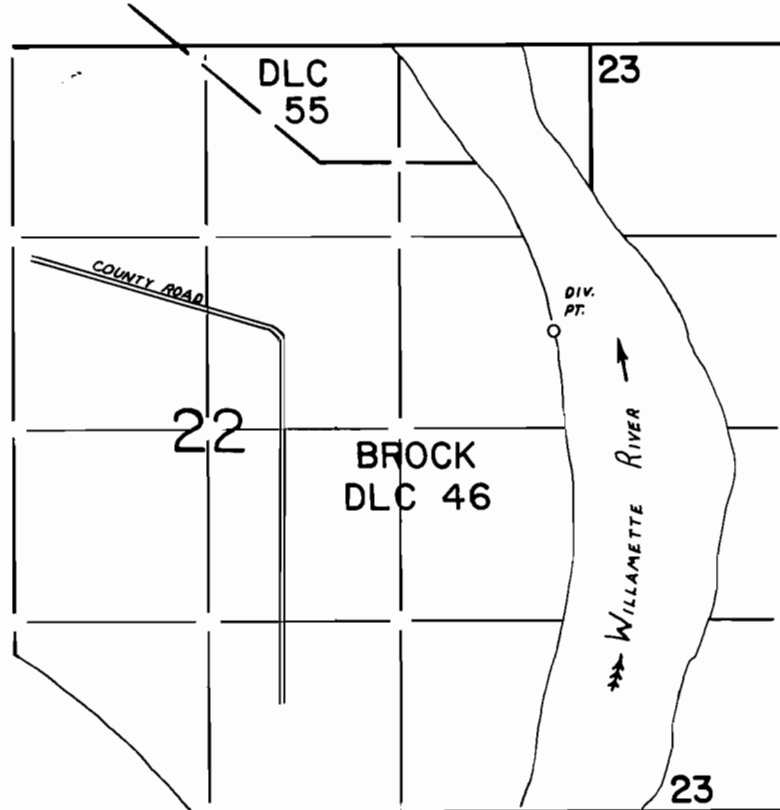

DIV. PT. LOCATED: 3340 FT N & 2325 E FROM S 1/4 CORNER SECTION 22

## FINAL PROOF SURVEY UNDER

Transfer No. ....5823.....  
 Application No. .... Permit No. ....  
 IN NAME OF

.....GARNET PANKEY.....

Surveyed JULY...22... 1987., by T.M. WARREN.....