


# T.4 & 5 S., R.1 W., W.M.

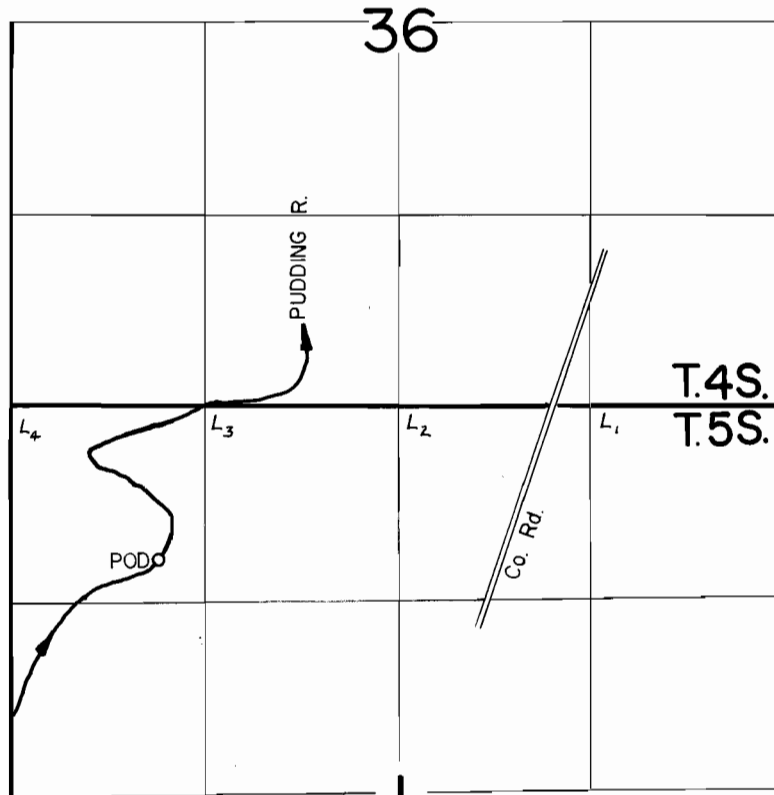

P.O.D. Loc. : 1630' N. & 1010' E. from W. 1/4 Cor. Sec. 1.

Scale: 1" = 1320'

## FINAL PROOF SURVEY UNDER

TRANSFER 4125

Application No. .... Permit No. ....

IN NAME OF

**IGNATI SNEGIREV**

Surveyed JULY 16, 1985, by T. Warren