


T. 5N.R. 4W.W.M.

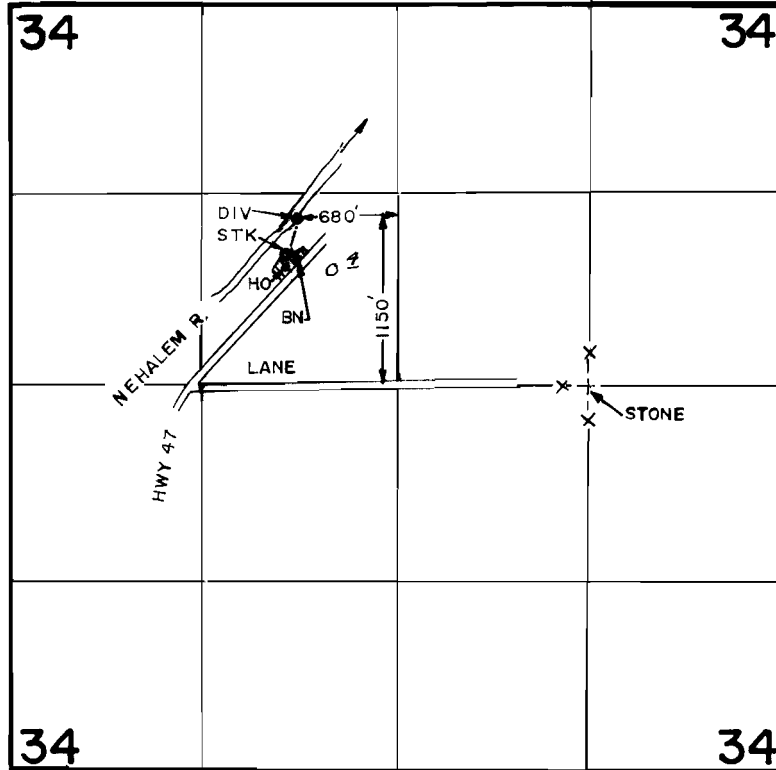

FINAL PROOF SURVEY UNDER

Application No. ~~50654~~ Permit No. ~~38269~~.....
IN NAME OF

.....SHERIDAN ANDREW THIRINGER.....

Surveyed MAY 20, 1980., by R.G. MUCKEN....