


# T. 28 S., R. 14 W., W.M.

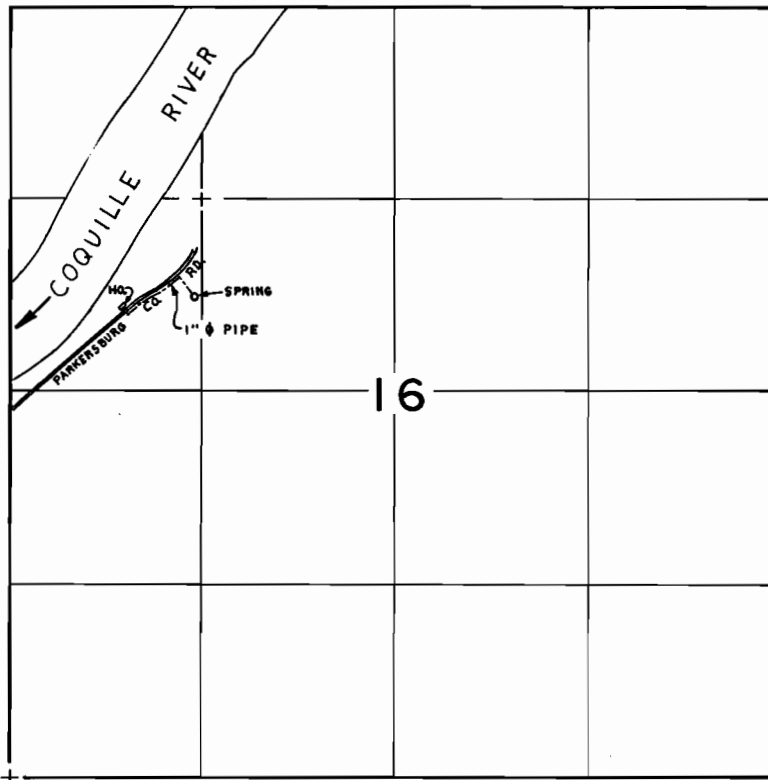

SPRING LOCATED 670' S. & 50' W. FROM N.W. 1/16 CORNER SECTION 16

SCALE: 4" = 1 mile

## FINAL PROOF SURVEY UNDER

Application No. 56560 Permit No. 42079.....  
IN NAME OF

.....SHELDON D. WARREN.....

Surveyed NOV. 3... 1983.. by L. CASHION.....