


T. 27S., R. 12W., W.M.

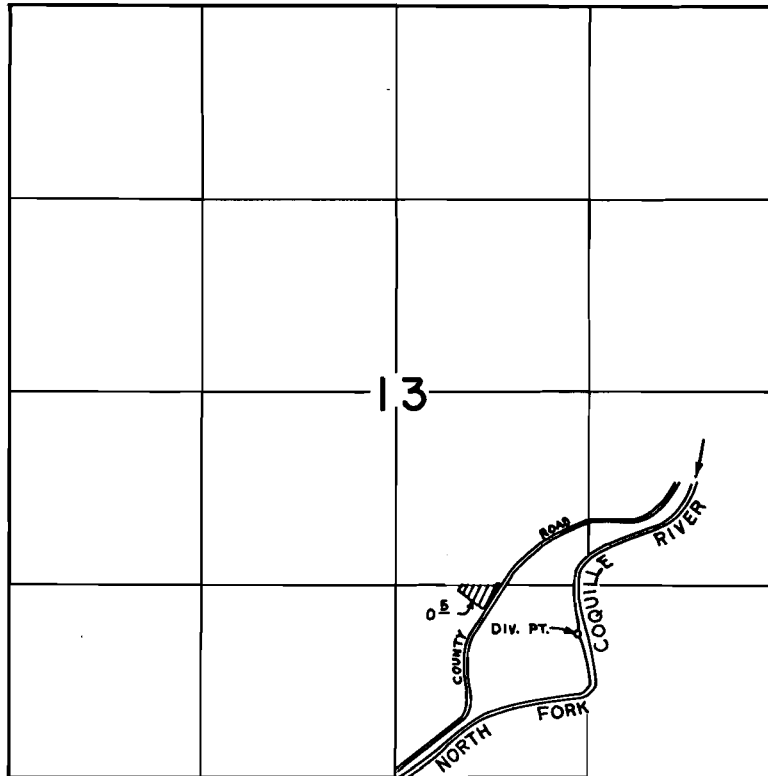

DIV. PT. LOC: 970' N. & 1280' E. FROM S. 1/4 CORNER, SEC. 13

SCALE : 4" = 1 mile

FINAL PROOF SURVEY UNDER

Application No. ~~62040~~ Permit No. ~~46343~~.....
IN NAME OF

~~CHARLES F. SHARPE~~.....

Surveyed ~~AUG. 31, 1983~~, by ~~P. THRELKELD~~