


T. 28 S., R. 14 W., W.M.

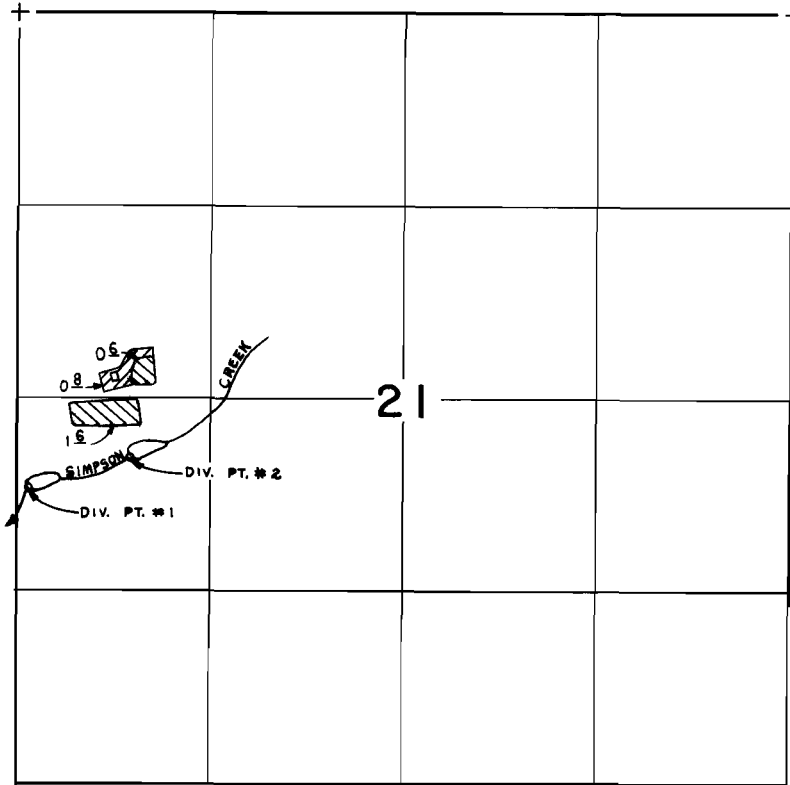

DIV. PT. #1 LOCATED 610'S. & 80'E. FROM W. 1/4 CORNER SECTION 21
 DIV. PT. #2 LOCATED 400'S. & 77'E. FROM W. 1/4 CORNER SECTION 21

IRRIGATION

IRRIGATION, TEMPERATURE CONTROL, & FLOOD HARVESTING.

SCALE: 4"=1mile

FINAL PROOF SURVEY UNDER

Application No. 61859 Permit No. 46463.....
 IN NAME OF

W. J. PULLEN

Surveyed NOV. 2, 1983, by L. CASHION.....