


T. 31 S. R. 15 W. W.M.

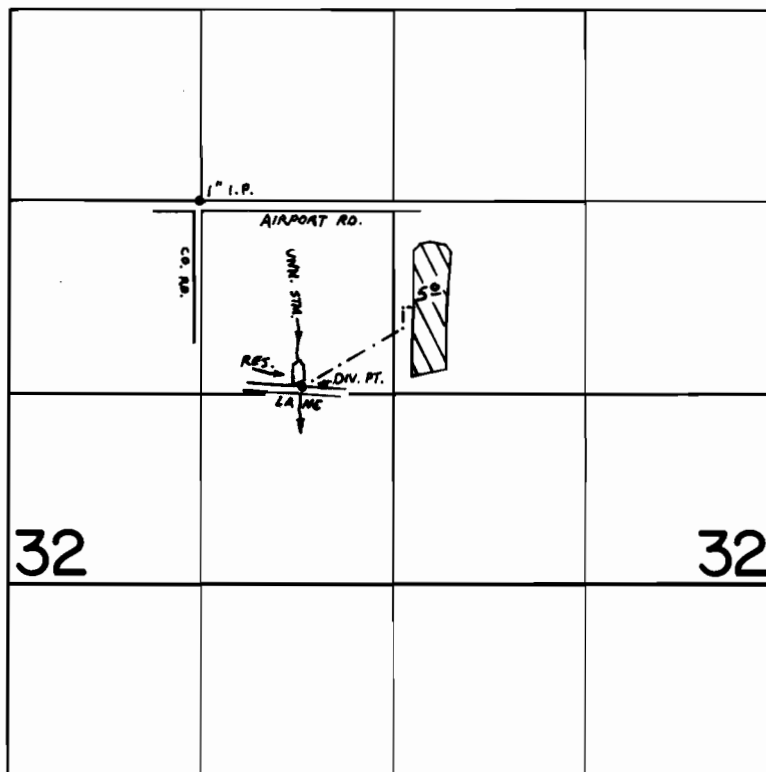

DIVERSION POINT LOCATED 1280' S. & 680' E. FROM THE NW COR. OF THE NE⁴SW⁴

FINAL PROOF SURVEY UNDER

Application No. 47013..... Permit No. 35172.....
IN NAME OF

CHARLES C. and ALEXANDER C. ELLS

Surveyed OCT. 21... 1976., by L.E. GOULD.....
Resurvey July 8, 1980 by J. S. Donaldson