


T.41S., R.13W., W.M.

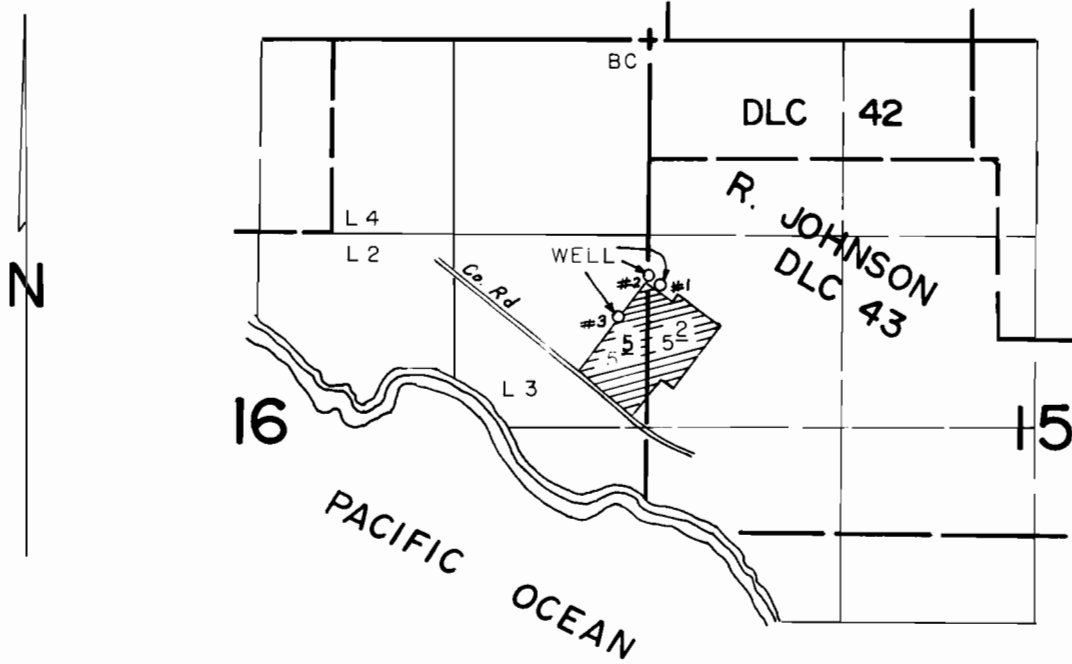

WELL LOCATIONS:

- 2) 1610' S. 5' E.
- 3) 1900' S. 200' W.

ALL FROM NW COR.
SEC. 15

SCALE: 4" = 1 mile

FINAL PROOF SURVEY

UNDER

Application No. G-7463 G-7855
G-9551 Permit No. G-9385.....
IN NAME OF

HENRY, KELLY, & ROBIN ITZEN

Surveyed APR. 10, 1985, by B. S. JAMES.....