


# T. 23S., R. 7W., W.M.

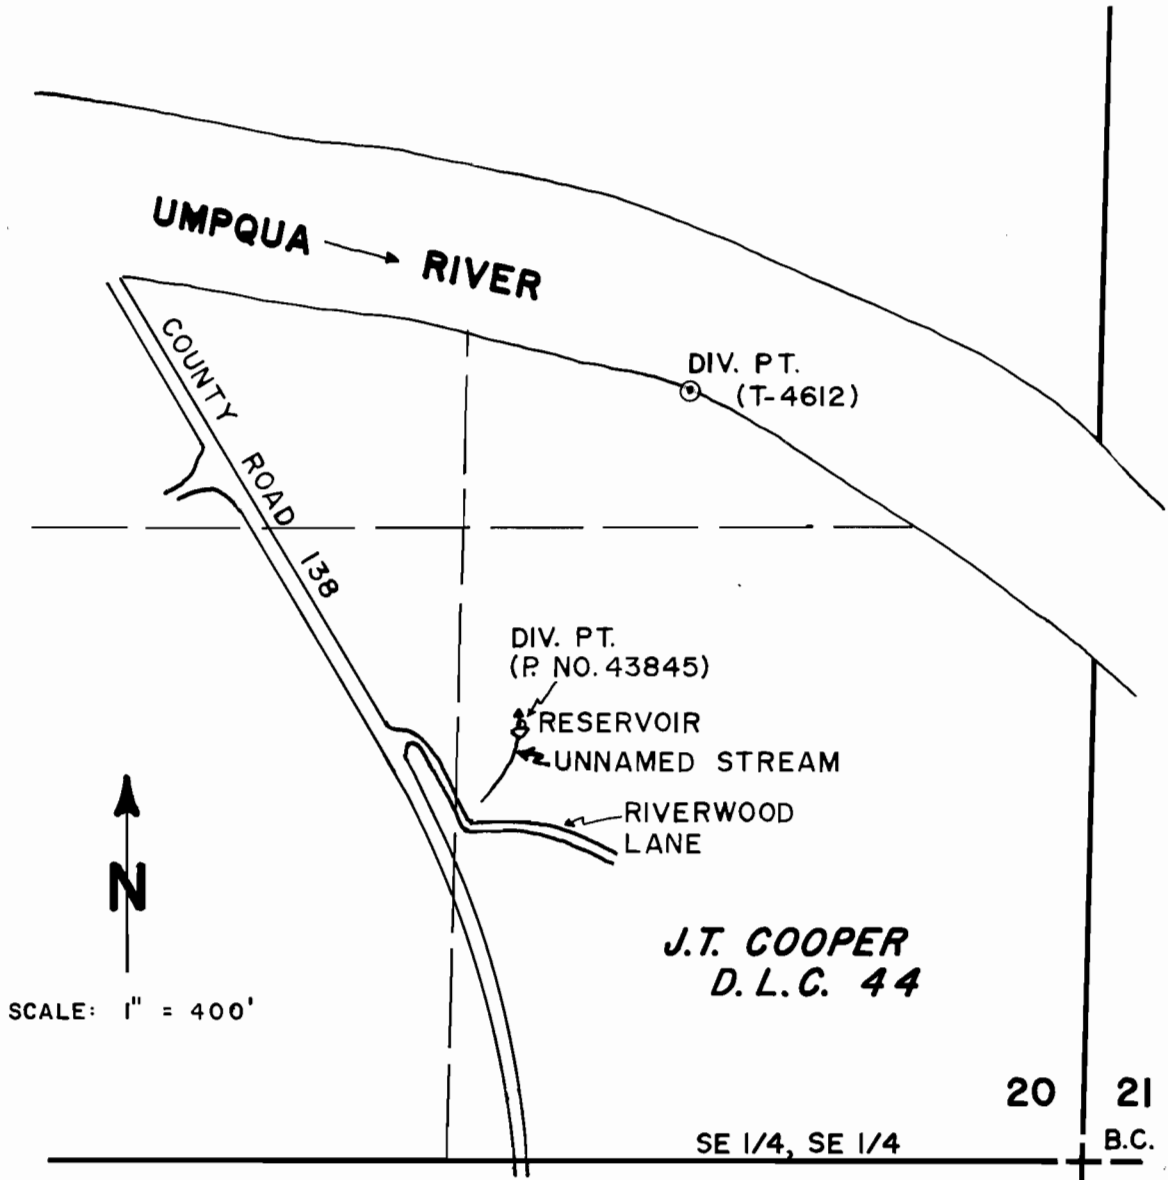

SCALE: 1" = 400'

**J.T. COOPER**  
**D.L.C. 44**

DIV. PT. (P-43845) LOCATED 910' N. & 970' W. OF SE COR. SEC. 20'  
DIV. PT. (T-4612) LOCATED 1610' N. & 820' W OF SE. COR. SEC. 20.

## FINAL PROOF SURVEY UNDER

T-4612      OC - 44464  
57896      43845  
Application No. R-57385 Permit No. R-7787  
IN NAME OF

**ANTONIO CALDERONE**

Surveyed AUG. 21 1986, by J. M. SCHMORDE