


T. 23 S. R. 5 W. W.M.

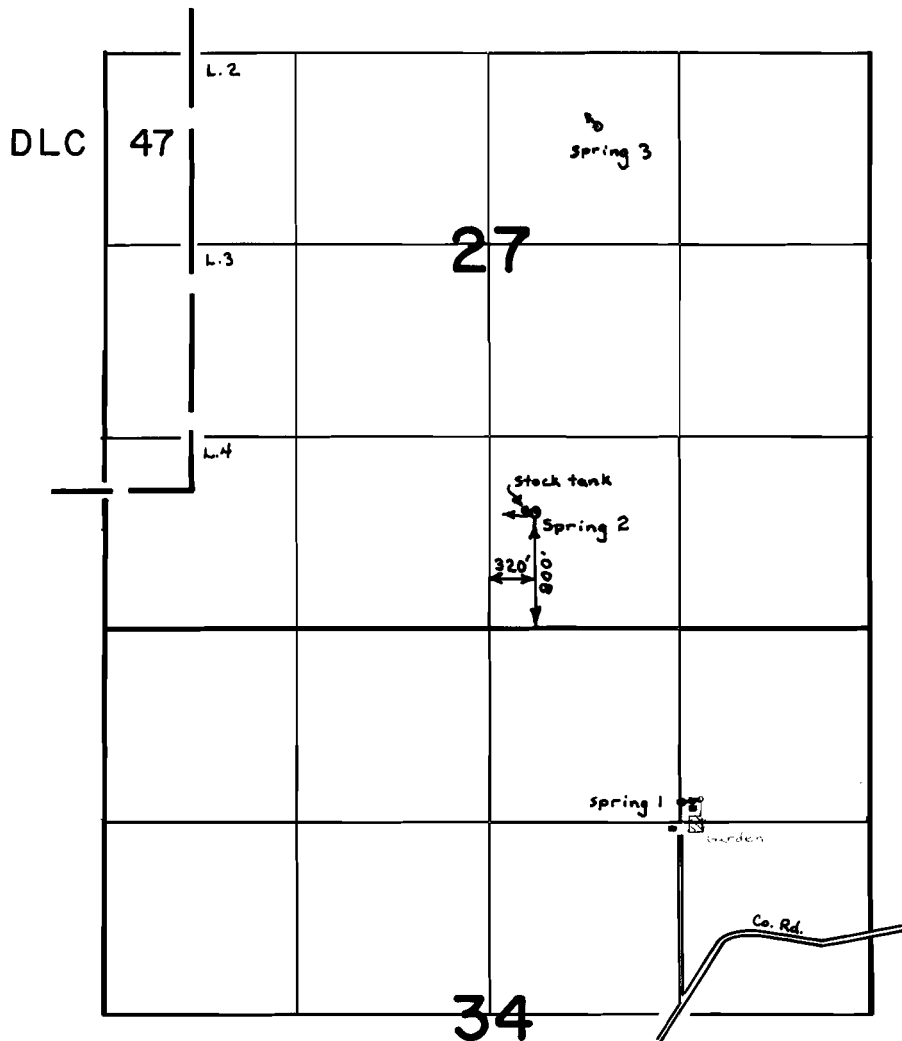

SCALE: 4" = 1 mile

FINAL PROOF SURVEY
UNDER

Application No. 51584 Permit No. 38910
IN NAME OF

FRED H. HOWELL

Surveyed Oct. 2 1979, by S. Donaldson