


# T.26S., R.5W., W.M.

## SECTION 7

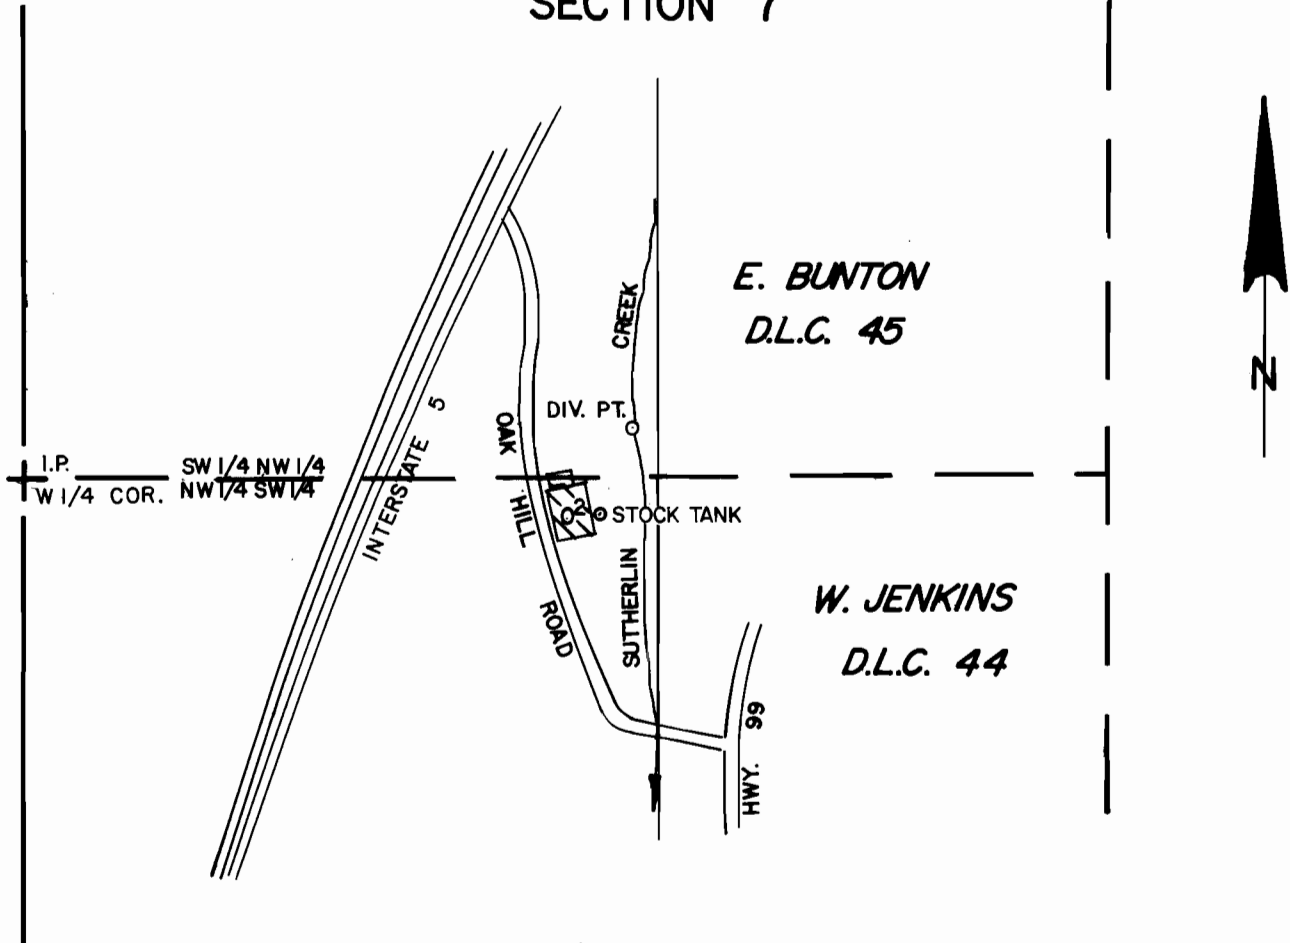

DIV. PT. LOCATED 100' N. & 1270' E. FROM W. 1/4 CORNER SECTION 7

SCALE: 1" = 400'

### FINAL PROOF SURVEY UNDER

Application No. **59247**.. Permit No. **44547**.....  
IN NAME OF

.....**JAMES M. DAVIS**.....

Surveyed **JUNE 25 1985**, by **J.M. SCHMORDE**..