


T. 26 S., R. 3 W., W.M.

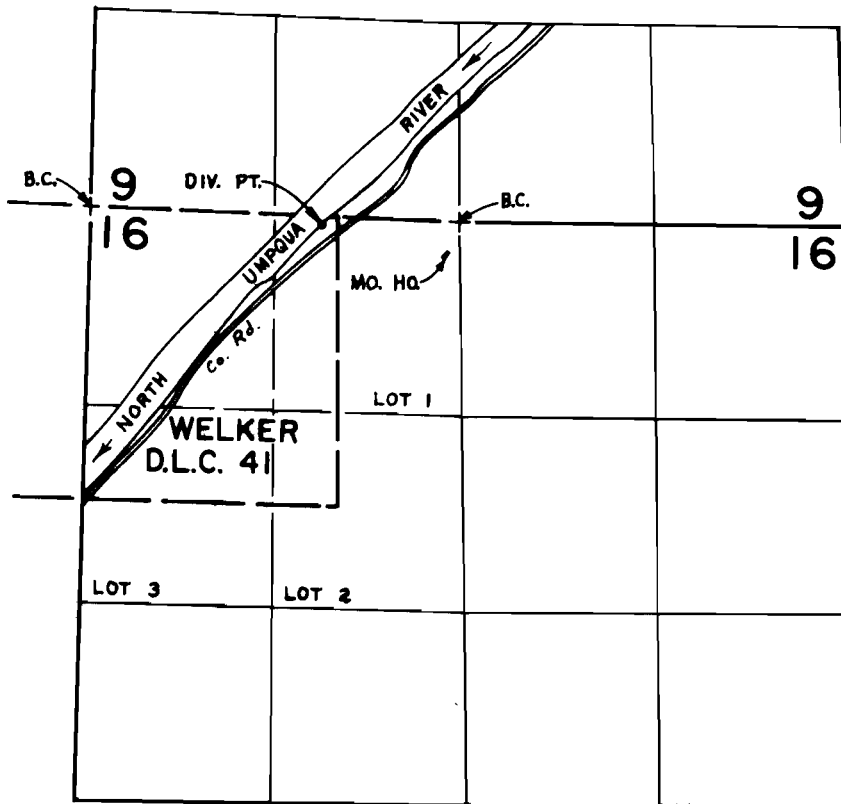

DIV. PT. LOCATED 15'S. & 940' W. FROM N. 1/4 COR. SEC. 16

SCALE: 4" = 1 mile

FINAL PROOF SURVEY UNDER

Application No. ~~60454~~... Permit No. ~~45256~~.....
IN NAME OF

..BRUCE W. ENGELBRECHT..

Surveyed JUL 26, 1984, by L. CASHION.....