



41703
56099

T.13S.,R.30E.,W.M.

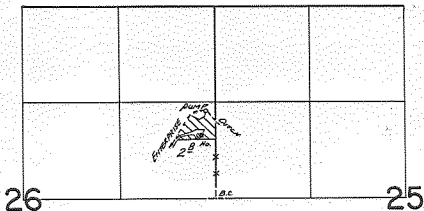

T.13S.,R.31E.,W.M.

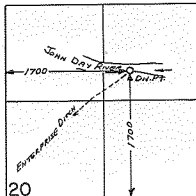

FINAL PROOF SURVEY
UNDER

Application No. 55570.. Permit No. 41703.....

IN NAME OF

FRED & CHERI MOORE.....

Surveyed Sept. 6... 1983., by R. W. Catta.....