


# T.2N. R. 10E.W.M.

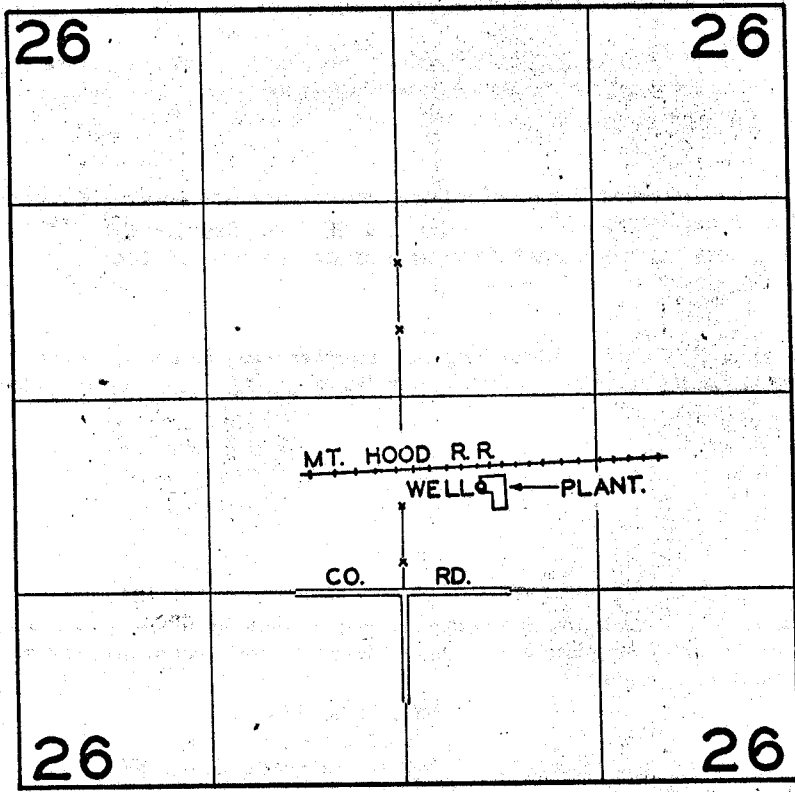

## FINAL PROOF SURVEY UNDER

Application No. 6974 Permit No. 6890  
IN NAME OF

DUCKWALL BROS., INC.

Surveyed NOV. 1 1960, by C. O. BARTELS