


T. 38 S., R. 4 W., W.M.

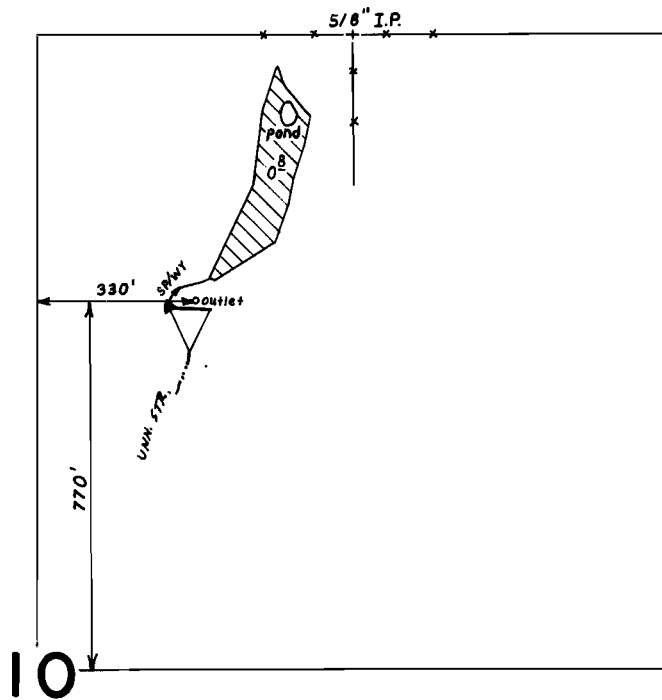

Scale: 1" = 400'

FINAL PROOF SURVEY
UNDER

Application No. R-49217 49218 Permit No. R-5987 36893
IN NAME OF

.....KENNETH R. CHAPMAN.....

Surveyed JUNE 23 19.82, by BRUCE R. SUND