


T. 36 S., R. 3 W., W. M.

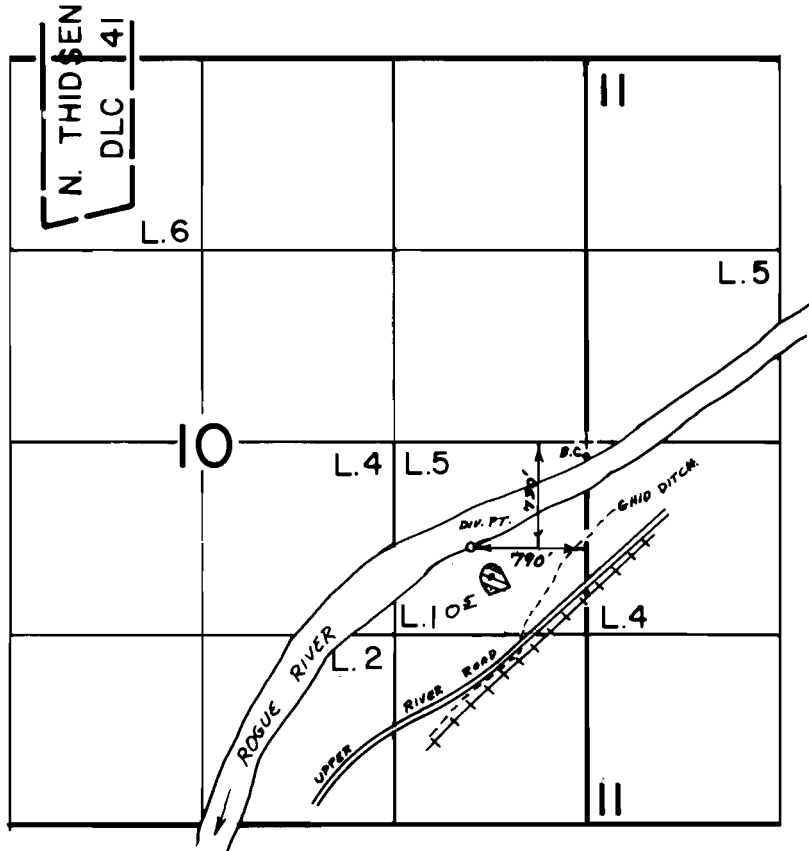

Scale 4" = 1 mile

FINAL PROOF SURVEY UNDER

Application No. 53319..... Permit No. 39562.....
IN NAME OF

..... KAREN D. WESTLAKE

Surveyed Nov. 17, 1981, by Bruce R. Sund.....