T. 40 S., R. 3 W. W.M.

Sec. 18

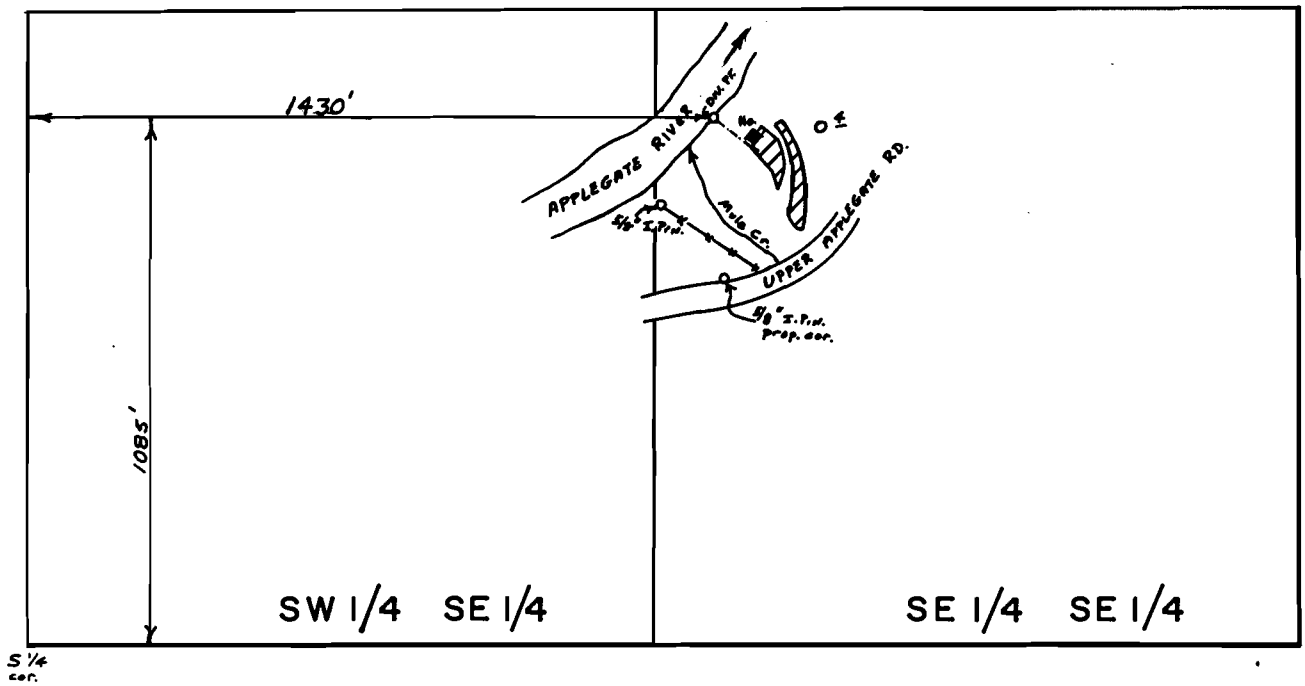

Scale 1" = 400'

FINAL PROOF SURVEY

UNDER

Application No. 55876 Permit No. 42049

IN NAME OF

KEITH & GWEN H. JOHNSON

Surveyed Sept. 24, 1980, by B.R. SUND

PTS-1980-14-A BSJ