
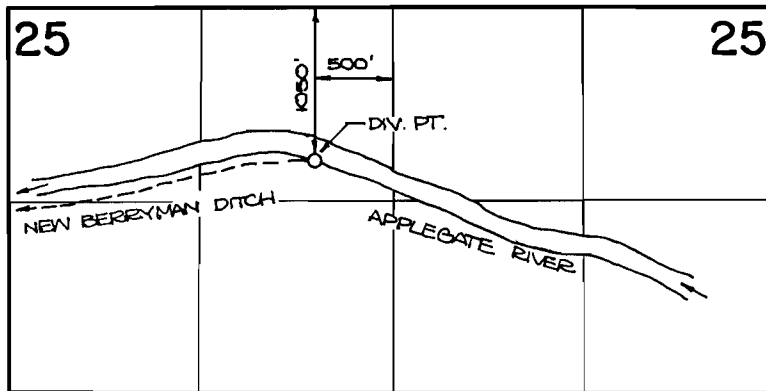


T.38S. R.4W. W.M.

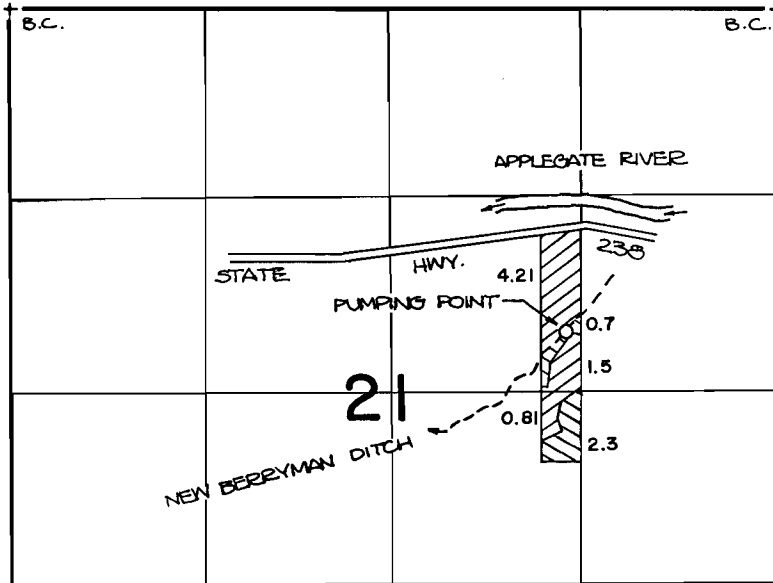

 PRIMARY  SUPPLEMENTAL

FINAL PROOF SURVEY

UNDER

Application No. 61798 Permit No. 45932
IN NAME OF

C. LOREN BOWMAN

Surveyed JUNE 23, 1982, by B. SUND