
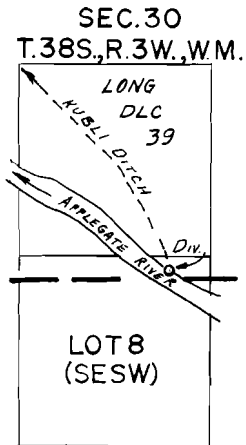


# T.38S.,R.4W.,W.M.

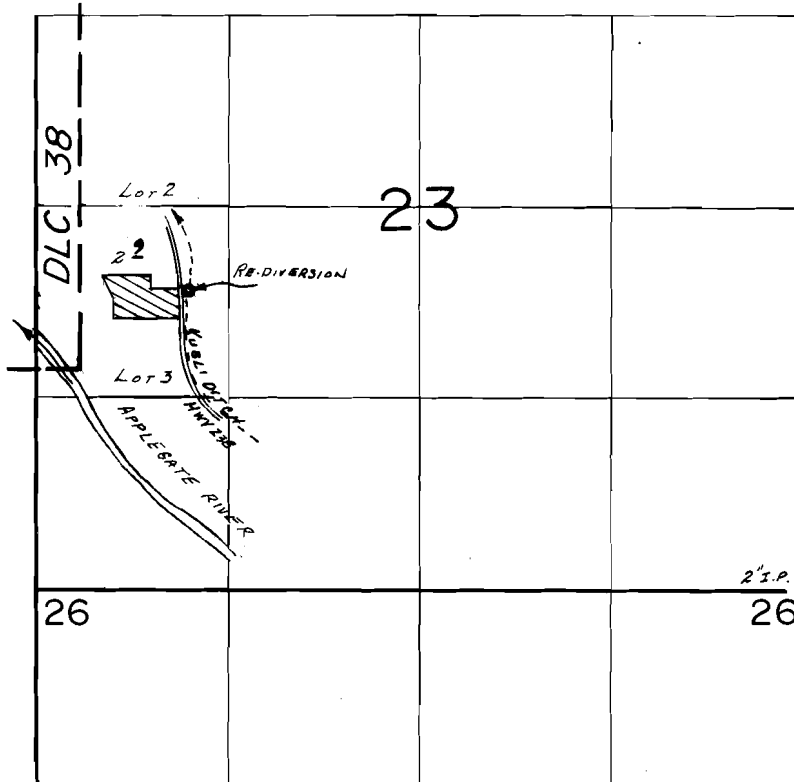

Div. Pt. Loc.: 2510 S. & 3370 W. FROM NE COR. LONG DLC 39, SEC. 30, T. 38S., R. 3 W., W.M.

SCALE: 1" = 1320'

## FINAL PROOF SURVEY UNDER

Application No. 62605... Permit No. 46142.....  
IN NAME OF

...LESLIE &/or ELAINE HESSON...

Surveyed ..Aug. 27... 19.85., by B.S. JAMES.....